

IS PLAN IS AN AMENDMENT TO REFERENCE PLAN NO. 3:
VERALL SITE PLAN AMENDMENT, CARRIAGE LANDING - BRISTOL
NTE NO. 2, 294 YORK STREET, YORK, MAINE" APPROVED BY THE
WN OF YORK PLANNING BOARD ON JUNE 17, 2025. THE
DPOSED AMENDMENT INCLUDES ADDITIONAL REARYARD
RKING AND CHANGES TO ON-SITE STORMWATER MANAGEMENT
LATED TO THE EXISTING MUNICIPAL DRAINAGE EASEMENT.

AMENDED DEVELOPED CONDITIONS PLAN
CARRIAGE LANDING – BRISTOL POINTE #2
294 YORK STREET, YORK, MAINE

GRAYSTONE BUILDERS, INC.
WALTER WOODS, 764 U.S. ROUTE 1, SUITE #11
YORK, ME 03909


<h1 style="text-align: center;"><u>ATTAR ENGINEERING, INC.</u></h1> <p style="text-align: center;">CIVIL ◆ STRUCTURAL ◆ MARINE ◆ SURVEYING 1284 STATE ROAD – ELIOT, MAINE 03903 PHONE: (207)439-6023 FAX: (207)439-2128</p>		
SCALE: " = 10'	APPROVED BY:	DRAWN BY: MJS
DATE: /09/2026		REVISION DATE: A : 01/22/26
NO: 24008	FILE: 294 YORK ST BASE.DWG	SHEET: 3

APPROVAL OF THE TOWN OF YORK PLANNING BOARD

CHAIR DAT

STATE OF MAINE - YORK COUNTY
ss. REGISTRY OF DEEDS
RECEIVED _____, 20_____
AT ____h, ____m, ____M, AND RECORDED IN
PLAN BOOK _____, PAGE _____
ATTEST _____ REGISTER _____

GRAPHIC SCALE

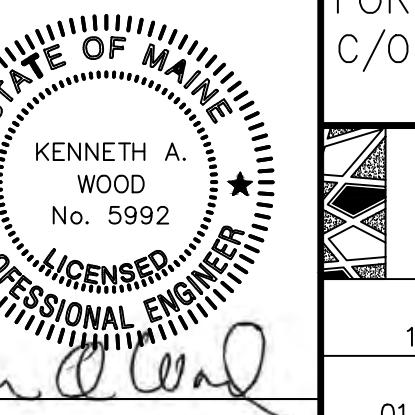

EROSION & SEDIMENTATION CONTROL NOTES

- PRIOR TO ANY SNOW EVENT, SILTATION FENCE OR HAY BALE BARRIERS WILL BE INSTALLED DOWNSLOPE OF ALL STRIPPING OR CONSTRUCTION OPERATIONS. A DOUBLE SILT FENCE BARRIER SHALL BE INSTALLED DOWNSLOPE OF ANY SOIL MATERIAL STOCKPILES. SILT FENCES SHALL BE INSPECTED AFTER EACH RAIN EVENT AND DAILY DURING PROLONGED RAIN. SILT AND SOIL PARTICLES ACCUMULATING BEHIND THE FENCE SHALL BE REMOVED AFTER EACH SIGNIFICANT RAIN EVENT AND IN NO INSTANCE SHOULD ACCUMULATION EXCEED 1/2 THE HEIGHT OF THE FENCE. TORN OR DAMAGED AREAS SHALL BE REPAIRED.
- TEMPORARY AND PERMANENT VEGETATION AND MULCHING IS AN INTEGRAL COMPONENT OF THE EROSION AND SEDIMENTATION CONTROL PLAN. ALL AREAS SHALL BE INSPECTED AND MAINTAINED UNTIL THE DESIRED VEGETATIVE COVER IS ESTABLISHED. THESE CONTROL MEASURES ARE ESSENTIAL TO EROSION PREVENTION AND ALSO REDUCE COSTLY REWORK OF GRADED AND SHAPED AREAS.
- SEEDING, FERTILIZER AND LIME RATES AND TIME OF APPLICATION WILL BE DEPENDENT ON SOIL REQUIREMENTS. TEMPORARY VEGETATION SHALL BE MAINTAINED IN THESE AREAS UNTIL PERMANENT SEEDING IS APPLIED. ADDITIONALLY, EROSION AND SEDIMENTATION MEASURES SHALL BE MAINTAINED UNTIL PERMANENT VEGETATION IS ESTABLISHED.
- ALL LAWN AREA, OUTER POND SIDE SLOPES AND SWALES SHALL BE PERMANENTLY SEEDED WITH THE FOLLOWING MIXTURE: 20 LB/ACRE CREEPING RED FESCUE, 2 LB/ACRE REDTOP AND 20 LB/ACRE TALL FESCUE FOR A TOTAL OF 42 LB/ACRE. FERTILIZER AND LIME RATES SHALL BE DEPENDENT ON SOIL TESTING. IN THE ABSENCE OF SOIL TESTS, FERTILIZE WITH 10-20-20 (N-P-205-K201) AT 800 LB/ACRE AND LIME AT 3 TONS/ACRE. MULCH WITH HAY AT 70-90 LB/1000 S.F. 4" OF LOAM SHALL BE APPLIED PRIOR TO SEEDING.
- POND BOTTOMS AND INNER POND SIDESLOPES SHALL BE PERMANENTLY SEEDED WITH THE FOLLOWING MIXTURE: 20 LB/ACRE CREEPING RED FESCUE, 8 LB/ACRE BIRDFOOT TREFOIL AND 20 LB/ACRE TALL FESCUE FOR A TOTAL OF 48 LB/ACRE. SEE THE ABOVE NOTE FOR FERTILIZER, LIME AND MULCHING RATES.
- TEMPORARY VEGETATION OF ALL DISTURBED AREAS, MATERIAL STOCKPILES AND OTHER SUCH AREAS SHALL BE ESTABLISHED BY SEEDING WITH EITHER WINTER RYE AT A RATE OF 112 LB/ACRE OR ANNUAL RYEGRASS AT A RATE OF 40 LB/ACRE. WINTER RYE SHALL BE USED FOR FALL SEEDING AND ANNUAL RYEGRASS FOR SHORT DURATION SEEDING. SEEDING SHALL BE ACCOMPLISHED BEFORE OCTOBER 1. TEMPORARY STABILIZATION WITH MULCH OF DISTURBED AREAS SHALL TAKE PLACE WITHIN 7 DAYS OF THE CESSION OF CONSTRUCTION ACTIVITIES IN AN AREA THAT WILL NOT BE WORKED FOR MORE THAN 7 DAYS. AREAS WITHIN 75 FEET OF A WETLAND OR WATERBODY SHALL BE TEMPORARILY STABILIZED WITH MULCH WITHIN 48 HOURS OF THE INITIAL DISTURBANCE OR PRIOR TO ANY STORM EVENT, WHICHEVER COMES FIRST.
- TEMPORARY SEEDING OF DISTURBED AREAS SHALL BE ACCOMPLISHED BEFORE OCTOBER 1. PERMANENT SEEDING SHALL BE ACCOMPLISHED BEFORE SEPTEMBER 15.
- ALL SEEDED AREAS SHALL BE MULCHED WITH HAY AT A RATE OF 2 BALES (70-90 LB) PER 1000 S.F. OF SEDED AREA.
- ALL DISTURBED AREAS ON THE SITE SHALL BE PERMANENTLY STABILIZED WITHIN 7 DAYS OF FINAL GRADING OR TEMPORARILY STABILIZED PER E&S NOTE 6. PERMANENT STABILIZATION MEANS 90% COVER WITH MATURE, HEALTHY PLANTS FOR PLANTED AREAS AND FOR SODDED AREAS, COMPLETE BINDING OF SOD ROOTS INTO THE UNDERLYING SOIL WITH NO SLUMPING OF THE SOD OR DIE-OFF.
- A STABILIZED CONSTRUCTION ENTRANCE SHALL BE INSTALLED AT ALL ACCESSES TO PUBLIC ROADS (SEE PLAN). TEMPORARY CULVERTS SHALL BE PROVIDED AS REQUIRED.
- SLOPES BETWEEN 2:1 AND 3:1 (INCLUDING 3:1) SHALL BE TREATED WITH POLYJUTE OPEN WEAVE GEOTEXTILE (OR EQUIVALENT) AFTER SEEDING. JUTE MATS SHALL BE ANCHORED PER MANUFACTURER'S SPECIFICATIONS. SLOPES BETWEEN 2:1 AND 1.5:1 (INCLUDING 2:1) SHALL BE ANCHORED WITH RIPRAP. SLOPES ARE PROHIBITED FROM BEING STEEPER THAN 1.5:1.
- EXCESSIVE DUST CAUSED BY CONSTRUCTION OPERATIONS SHALL BE CONTROLLED BY APPLICATION OF WATER OR CALCIUM CHLORIDE.
- THE CONTRACTOR MAY OPT TO USE EROSION CONTROL MIX BERM AS A SEDIMENT BARRIER IN LIEU OF SILTATION FENCE OR HAY BALE BARRIERS WITH APPROVAL FROM THE INSPECTING ENGINEER.
- SEDIMENT BARRIERS SHALL BE DOUBLED WITH 75' OF WETLANDS OR OTHER PROTECTED NATURAL RESOURCES.
- TEMPORARY E&S CONTROL MEASURES SHALL BE REMOVED WITHIN 30 DAYS OF PERMANENT STABILIZATION. ACCUMULATED SEDIMENTS SHALL BE REMOVED AND THE AREA STABILIZED.
- THE CONTRACTOR SHALL BE RESPONSIBLE FOR ADEQUATE HOUSEKEEPING PRACTICES DURING THE CONSTRUCTION OF THE PROJECT. THESE STANDARDS CAN BE FOUND IN THE FOLLOWING DOCUMENT: MDEP CHAPTER 500 (STORMWATER MANAGEMENT), APPENDIX C, HOUSEKEEPING. HOUSEKEEPING PRACTICES INCLUDE, BUT ARE NOT LIMITED TO, SPILL PREVENTION, GROUNDWATER PROTECTION, FUGITIVE SEDIMENT AND DUST, DEBRIS AND OTHER MATERIALS, EXCAVATION DEWATERING, AUTHORIZED NON-STORMWATER DISCHARGES AND UNAUTHORIZED NON-STORMWATER DISCHARGES. ANY SPILL OR RELEASE OF HAZARDOUS SUBSTANCES MUST BE REPORTED TO THE MDEP; FOR OIL SPILLS, CALL 1-800-482-0777; FOR SPILLS OF TOXIC OR HAZARDOUS MATERIAL, CALL 1-800-452-4664.
- WHENEVER PRACTICABLE, NO DISTURBANCE ACTIVITIES SHOULD TAKE PLACE WITHIN 50 FEET OF ANY PROTECTED NATURAL RESOURCE. IF DISTURBANCE ACTIVITIES TAKE PLACE BETWEEN 30 FEET AND 50 FEET OF ANY PROTECTED NATURAL RESOURCE, AND STORMWATER DISCHARGES THROUGH THE DISTURBED AREAS TOWARD THE PROTECTED NATURAL RESOURCE, PERIMETER EROSION CONTROLS MUST BE DOUBLED. IF DISTURBANCE ACTIVITIES TAKE PLACE LESS THAN 30 FEET FROM ANY PROTECTED NATURAL RESOURCE, AND STORMWATER DISCHARGES THROUGH THE DISTURBED AREAS TOWARD THE PROTECTED NATURAL RESOURCE, PERIMETER EROSION CONTROLS MUST BE DOUBLED AND DISTURBED AREAS MUST BE TEMPORARILY OR PERMANENTLY STABILIZED WITHIN 7 DAYS.
- ALL SEDIMENT BARRIERS AND EROSION CONTROL MEASURES SHALL BE INSTALLED PRIOR TO THE START OF CONSTRUCTION.
- SEDIMENT BARRIERS SHALL BE INSTALLED DOWN-GRADIENT OF STOCKPILES, AND STORMWATER SHALL BE PREVENTED FROM RUNNING ONTO STOCKPILES.
- THE PROPOSED STORMWATER MANAGEMENT AREAS INTENDED FOR USE AS PERMANENT, POST-CONSTRUCTION BMP'S SHALL BE USED TO TEMPORARILY MANAGE FLOWS DURING CONSTRUCTION. THESE BMP'S SHALL BE MAINTAINED DURING THEIR TEMPORARY USE BY INSTALLING THE APPROPRIATE MEASURES DURING CONSTRUCTION, INCLUDING UNDERDRAINS, SOIL FILTER MEDIA, ETC. SEDIMENT REMOVAL AND SLOPE STABILIZATION SHALL TAKE PLACE AS NECESSARY FOR TEMPORARY CONSTRUCTION MANAGEMENT.
- THE CONTRACTOR SHALL BE RESPONSIBLE FOR ADEQUATE HOUSEKEEPING PRACTICES DURING THE CONSTRUCTION OF THE PROJECT. THESE STANDARDS CAN BE FOUND IN THE FOLLOWING DOCUMENT: MDEP CHAPTER 500 (STORMWATER MANAGEMENT), APPENDIX C, HOUSEKEEPING. HOUSEKEEPING PRACTICES INCLUDE, BUT ARE NOT LIMITED TO, SPILL PREVENTION, GROUNDWATER PROTECTION, FUGITIVE SEDIMENT AND DUST, DEBRIS AND OTHER MATERIALS, EXCAVATION DEWATERING, AUTHORIZED NON-STORMWATER DISCHARGES AND UNAUTHORIZED NON-STORMWATER DISCHARGES (DETAILED BELOW).

CONSTRUCTION HOUSEKEEPING PUNCHLIST

- ALL DISTRIBUTED AREAS SHALL BE PERMANENTLY STABILIZED, AND PLANTINGS SHALL BE ESTABLISHED (GRASS SEEDS HAVE GERMINATED WITHIN 90% VEGETATIVE COVER).
- ALL TRASH, SEDIMENTS, DEBRIS, OR ANY SOLID WASTE SHALL BE REMOVED FROM STORMWATER CHANNELS, CATCH BASINS, DETENTION STRUCTURES, DISCHARGE POINTS, AND LEVEL SPREADERS.
- ALL EROSION AND SEDIMENTATION DEVICES SHALL BE REMOVED (SILTATION FENCES AND POSTS, DIVERSIONS AND SEDIMENT STRUCTURES, ETC.)
- ALL DELIVERABLES (CERTIFICATIONS, SURVEY INFORMATION, AS-BUILT PLANS, REPORTS, NOTICES OF TERMINATION, ETC.) IN ACCORDANCE WITH ALL PERMIT REQUIREMENTS SHALL BE SUBMITTED TO THE TOWN, THE MAINE DEP, HOMEOWNER'S ASSOCIATION, OWNER, AND/OR ALL APPROPRIATE ENTITIES.

E&S INSPECTION/MAINTENANCE DURING CONSTRUCTION

- INSPECTION AND CORRECTIVE ACTION. INSPECT DISTURBED AND IMPERVIOUS AREAS, EROSION CONTROL MEASURES, MATERIALS STORAGE AREAS THAT ARE EXPOSED TO PRECIPITATION, AND LOCATIONS WHERE VEHICLES ENTER OR EXIT THE SITE. INSPECT THESE AREAS AT LEAST ONCE A WEEK, PRIOR TO COMPLETING PERMANENT STABILIZATION MEASURES, AS WELL AS BEFORE AND WITHIN 24 HOURS AFTER A STORM EVENT WHICH PRODUCES 0.5 INCHES OR MORE WITHIN SAID 24 HOUR PERIOD. A TOWN-APPOINTED ENGINEER WITH KNOWLEDGE OF EROSION AND STORMWATER CONTROL, INCLUDING THE STANDARDS AND CONDITIONS IN THE PERMIT, SHALL CONDUCT THE INSPECTIONS AND SHALL ALSO ENSURE THAT THE RECOMMENDED MAINTENANCE IS PERFORMED.
- MAINTENANCE. IF BEST MANAGEMENT PRACTICES (BMP'S) NEED TO BE REPAIRED, THE REPAIR WORK SHOULD BE INITIATED UPON DISCOVERY OF THE PROBLEM BUT NO LATER THAN THE END OF THE NEXT WORKDAY. IF ADDITIONAL BMP'S OR SIGNIFICANT REPAIR OF BMP'S ARE NECESSARY, IMPLEMENTATION MUST BE COMPLETED WITHIN 7 CALENDAR DAYS AND PRIOR TO ANY STORM EVENT WHICH PRODUCES 0.5 INCHES OR MORE WITHIN A 24 HOUR PERIOD. ALL MEASURES MUST BE MAINTAINED IN EFFECTIVE OPERATING CONDITION UNTIL AREAS ARE PERMANENTLY STABILIZED.
- DOCUMENTATION. KEEP A LOG (REPORT) SUMMARIZING THE INSPECTIONS AND ANY CORRECTIVE ACTION TAKEN. THE LOG MUST INCLUDE THE NAME(S) AND QUALIFICATIONS OF THE PERSON MAKING THE INSPECTIONS, THE DATE(S) OF THE INSPECTIONS, AND MAJOR OBSERVATIONS ABOUT THE OPERATION AND MAINTENANCE OF EROSION AND SEDIMENTATION CONTROLS, MATERIALS STORAGE AREAS, AND VEHICLES ACCESS POINTS. THE PARCEL, MAJOR OBSERVATIONS MUST INCLUDE BMP'S THAT NEED MAINTENANCE, AND LOCATIONS WHERE ADDITIONAL BMP'S ARE NEEDED. FOR EACH BMP REQUIRED MAINTENANCE, BMP NEEDING REPLACEMENT, AND LOCATION NEEDING ADDITIONAL BMP'S. NOTE IN THE LOG THE CORRECTIVE ACTION TAKEN AND WHEN IT WAS TAKEN. THE LOG MUST BE MADE ACCESSIBLE TO DEPARTMENT STAFF AND A COPY MUST BE PROVIDED UPON REQUEST. THE PERMITTEE SHALL RETAIN A COPY OF THE LOG FOR A PERIOD OF AT LEAST THREE YEARS FROM THE COMPLETION OF PERMANENT STABILIZATION.

WINTER CONSTRUCTION NOTES

(01 NOVEMBER THRU 15 APRIL)

- EXPOSED AREAS SHOULD BE LIMITED TO AN AREA THAT CAN BE MULCHED IN ONE DAY.
- AN AREA SHALL BE CONSIDERED STABILIZED WHEN EXPOSED SURFACES HAVE BEEN EITHER MULCHED WITH HAY AT A RATE OF 140-180 LB/1000 S.F. (DOUBLE THE NORMAL RATE) OR DORMANT, MULCHED AND ADEQUATELY ANCHORED BY AN APPROVED ANCHORING TECHNIQUE. IN ALL CASES, MULCH SHALL BE APPLIED SO THAT THE SOIL SURFACE IS NOT VISIBLE THROUGH THE MULCH.
- FROM OCTOBER 15 TO APRIL 1, LOAM AND SEED WILL NOT BE REQUIRED. DURING PERIODS OF TEMPERATURES ABOVE FREEZING, DISTURBED AREAS SHALL BE FINE GRADED AND PROTECTED WITH MULCH OR TEMPORARILY SEDED AND MULCHED UNTIL PERMANENT SEEDING CAN BE APPLIED. AFTER NOVEMBER 1, DISTURBED AREAS MAY BE LOAMED, FINE GRADED AND DORMANT SEDED AT A RATE 200-300% HIGHER THAN THE SPECIFIED PERMANENT SEEDING RATE. IF CONSTRUCTION CONTINUES DURING FREEZING WEATHER, DISTURBED AREAS SHALL BE GRADED BEFORE FREEZING AND TEMPORARILY STABILIZED WITH MULCH. DISTURBED AREAS SHALL NOT BE LEFT OVER THE WINTER OR FOR ANY OTHER EXTENDED PERIOD OF TIME UNLESS STABILIZED WITH MULCH.
- FROM NOVEMBER 1 TO APRIL 15 ALL MULCH SHALL BE ANCHORED BY EITHER PEG LINE, MULCH NETTING, TRACK OR WOOD CELLULOSE FIBER. MULCH NETTING SHALL BE USED TO ANCHOR MULCH IN ALL DRAINAGE WAYS WITH SLOPES GREATER THAN 3%, SLOPES EXPOSED TO DIRECT WINDS AND FOR SLOPES GREATER THAN 8%. MULCH NETTING SHALL BE USED TO ANCHOR MULCH IN ALL AREAS WITH SLOPES GREATER THAN 15%. AFTER OCTOBER 1, THE SAME APPLIES TO ALL SLOPES GREATER THAN 8%.
- DURING WINTER CONSTRUCTION, DORMANT SEEDING OR MULCH AND ANCHORING SHALL BE APPLIED TO ALL DISTURBED AREAS AT THE END OF EACH WORKING DAY.
- SNOW SHALL BE REMOVED FROM AREAS OF SEEDING AND MULCHING PRIOR TO PLACEMENT.
- ALL VEGETATED DITCH LINES THAT HAVE NOT BEEN STABILIZED BY NOVEMBER 1, OR WILL BE WORKED DURING THE WINTER CONSTRUCTION PERIOD, MEST BE STABILIZED WITH AN APPROPRIATE STONE LINING BACKED BY AN APPROPRIATE GRAVEL BED OR GEOTEXTILE UNLESS SPECIFICALLY RELEASED FROM THIS STANDARD BY THE MDEP.
- EXCESSIVE DUST CAUSED BY CONSTRUCTION OPERATIONS SHALL BE CONTROLLED BY APPLICATION OF WATER OR CALCIUM CHLORIDE.
- THE CONTRACTOR MAY OPT TO USE EROSION CONTROL MIX BERM AS A SEDIMENT BARRIER IN LIEU OF SILTATION FENCE OR HAY BALE BARRIERS WITH APPROVAL FROM THE INSPECTING ENGINEER.
- SEDIMENT BARRIERS SHALL BE DOUBLED WITH 75' OF WETLANDS OR OTHER PROTECTED NATURAL RESOURCES.
- TEMPORARY E&S CONTROL MEASURES SHALL BE REMOVED WITHIN 30 DAYS OF PERMANENT STABILIZATION. ACCUMULATED SEDIMENTS SHALL BE REMOVED AND THE AREA STABILIZED.
- THE CONTRACTOR SHALL BE RESPONSIBLE FOR ADEQUATE HOUSEKEEPING PRACTICES DURING THE CONSTRUCTION OF THE PROJECT. THESE STANDARDS CAN BE FOUND IN THE FOLLOWING DOCUMENT: MDEP CHAPTER 500 (STORMWATER MANAGEMENT), APPENDIX C, HOUSEKEEPING. HOUSEKEEPING PRACTICES INCLUDE, BUT ARE NOT LIMITED TO, SPILL PREVENTION, GROUNDWATER PROTECTION, FUGITIVE SEDIMENT AND DUST, DEBRIS AND OTHER MATERIALS, EXCAVATION DEWATERING, AUTHORIZED NON-STORMWATER DISCHARGES AND UNAUTHORIZED NON-STORMWATER DISCHARGES. ANY SPILL OR RELEASE OF HAZARDOUS SUBSTANCES MUST BE REPORTED TO THE MDEP; FOR OIL SPILLS, CALL 1-800-482-0777; FOR SPILLS OF TOXIC OR HAZARDOUS MATERIAL, CALL 1-800-452-4664.
- WHENEVER PRACTICABLE, NO DISTURBANCE ACTIVITIES SHOULD TAKE PLACE WITHIN 50 FEET OF ANY PROTECTED NATURAL RESOURCE. IF DISTURBANCE ACTIVITIES TAKE PLACE BETWEEN 30 FEET AND 50 FEET OF ANY PROTECTED NATURAL RESOURCE, AND STORMWATER DISCHARGES THROUGH THE DISTURBED AREAS TOWARD THE PROTECTED NATURAL RESOURCE, PERIMETER EROSION CONTROLS MUST BE DOUBLED. IF DISTURBANCE ACTIVITIES TAKE PLACE LESS THAN 30 FEET FROM ANY PROTECTED NATURAL RESOURCE, AND STORMWATER DISCHARGES THROUGH THE DISTURBED AREAS TOWARD THE PROTECTED NATURAL RESOURCE, PERIMETER EROSION CONTROLS MUST BE DOUBLED AND DISTURBED AREAS MUST BE TEMPORARILY OR PERMANENTLY STABILIZED WITHIN 7 DAYS.
- ALL SEDIMENT BARRIERS AND EROSION CONTROL MEASURES SHALL BE INSTALLED PRIOR TO THE START OF CONSTRUCTION.
- SEDIMENT BARRIERS SHALL BE INSTALLED DOWN-GRADIENT OF STOCKPILES, AND STORMWATER SHALL BE PREVENTED FROM RUNNING ONTO STOCKPILES.
- THE PROPOSED STORMWATER MANAGEMENT AREAS INTENDED FOR USE AS PERMANENT, POST-CONSTRUCTION BMP'S SHALL BE USED TO TEMPORARILY MANAGE FLOWS DURING CONSTRUCTION. THESE BMP'S SHALL BE MAINTAINED DURING THEIR TEMPORARY USE BY INSTALLING THE APPROPRIATE MEASURES DURING CONSTRUCTION, INCLUDING UNDERDRAINS, SOIL FILTER MEDIA, ETC. SEDIMENT REMOVAL AND SLOPE STABILIZATION SHALL TAKE PLACE AS NECESSARY FOR TEMPORARY CONSTRUCTION MANAGEMENT.
- THE CONTRACTOR SHALL BE RESPONSIBLE FOR ADEQUATE HOUSEKEEPING PRACTICES DURING THE CONSTRUCTION OF THE PROJECT. THESE STANDARDS CAN BE FOUND IN THE FOLLOWING DOCUMENT: MDEP CHAPTER 500 (STORMWATER MANAGEMENT), APPENDIX C, HOUSEKEEPING. HOUSEKEEPING PRACTICES INCLUDE, BUT ARE NOT LIMITED TO, SPILL PREVENTION, GROUNDWATER PROTECTION, FUGITIVE SEDIMENT AND DUST, DEBRIS AND OTHER MATERIALS, EXCAVATION DEWATERING, AUTHORIZED NON-STORMWATER DISCHARGES AND UNAUTHORIZED NON-STORMWATER DISCHARGES (DETAILED BELOW).

STORMWATER DISCHARGE REQUIREMENTS

AUTHORIZED NON-STORMWATER DISCHARGES. IDENTIFY AND PREVENT CONTAMINATION BY NON-STORMWATER DISCHARGES. WHERE ALLOWED NON-STORMWATER DISCHARGES EXIST, THEY MUST BE IDENTIFIED AND STEPS SHOULD BE TAKEN TO ENSURE THE IMPLEMENTATION OF APPROPRIATE POLLUTION PREVENTION MEASURES FOR THE NON-STORMWATER COMPONENT(S) OF THE DISCHARGE. AUTHORIZED NON-STORMWATER DISCHARGES ARE:

- DISCHARGES FROM FIREFIGHTING ACTIVITY;
- FIRE HYDRANT FLUSHINGS;
- VEHICLE WASHWATER IF DETERGENTS ARE NOT USED AND WASHING IS LIMITED TO THE EXTERIOR OF VEHICLES (ENGINE, UNDERCARRIAGE AND TRANSMISSION WASHING IS PROHIBITED);
- DUST CONTROL RUNOFF IN ACCORDANCE WITH PERMIT CONDITIONS AND APPENDIX (C)(3);
- ROUTINE EXTERNAL BUILDING WASHDOWN, NOT INCLUDING SURFACE PAINT REMOVAL, THAT DOES NOT INVOLVE DETERGENTS;
- PAVEMENT WASHWATER (WHERE SPILLS/LEAKS OF TOXIC OR HAZARDOUS MATERIALS HAVE NOT OCCURRED, UNLESS ALL SPILLED MATERIAL HAD BEEN REMOVED) IF DETERGENTS ARE NOT USED;
- UNCONTAMINATED AIR CONDITIONING OR COMPRESSOR CONDENSATE;
- UNCONTAMINATED GROUNDWATER OR SPRING WATER;
- UNCONTAMINATED EXCAVATION DEWATERING (SEE REQUIREMENTS IN APPENDIX C(5))
- PORTABLE WATER SOURCES INCLUDING WATERLINE FLUSHINGS
- LANDSCAPE IRRIGATION


UNAUTHORIZED NON-STORMWATER DISCHARGES. THE DEPARTMENTS APPROVAL UNDER THIS CHAPTER DOES NOT AUTHORIZE A DISCHARGE THAT IS MIXED WITH A SOURCE OF NON-STORMWATER, OTHER THAN THOSE DISCHARGES IN COMPLIANCE WITH APPENDIX C (6). SPECIFICALLY, THE DEPARTMENTS APPROVAL DOES NOT AUTHORIZE DISCHARGES OF THE FOLLOWING:

- WASTEWATER FROM THE WASHOUT OR CLEANOUT OF CONCRETE, STUCCO, PAINT, FORM RELEASE OILS, CURING COMPOUNDS OR OTHER CONSTRUCTION MATERIALS;
- FUELS, OILS OR OTHER POLLUTANTS USED IN VEHICLE AND EQUIPMENT OPERATION AND MAINTENANCE;
- SOAP, SOLVENTS, OR DETERGENTS USED IN VEHICLE AND EQUIPMENT WASHING; AND
- TOXIC OR HAZARDOUS SUBSTANCES FROM A SPILL OR OTHER RELEASE


- THE CONTRACTOR SHALL BE RESPONSIBLE FOR ADEQUATE HOUSEKEEPING PRACTICES DURING THE CONSTRUCTION OF THE PROJECT. THESE STANDARDS CAN BE FOUND IN THE FOLLOWING DOCUMENT: MDEP CHAPTER 500 (STORMWATER MANAGEMENT), APPENDIX C, HOUSEKEEPING. HOUSEKEEPING PRACTICES INCLUDE, BUT ARE NOT LIMITED TO, SPILL PREVENTION, GROUNDWATER PROTECTION, FUGITIVE SEDIMENT AND DUST, DEBRIS AND OTHER MATERIALS, EXCAVATION DEWATERING, AUTHORIZED NON-STORMWATER DISCHARGES AND UNAUTHORIZED NON-STORMWATER DISCHARGES (DETAILED BELOW).

CULVERT INLET/OUTLET PROTECTION DETAIL

- ALL DISTRIBUTED AREAS SHALL BE PERMANENTLY STABILIZED, AND PLANTINGS SHALL BE ESTABLISHED (GRASS SEEDS HAVE GERMINATED WITHIN 90% VEGETATIVE COVER).
- ALL TRASH, SEDIMENTS, DEBRIS, OR ANY SOLID WASTE SHALL BE REMOVED FROM STORMWATER CHANNELS, CATCH BASINS, DETENTION STRUCTURES, DISCHARGE POINTS, AND LEVEL SPREADERS.
- ALL EROSION AND SEDIMENTATION DEVICES SHALL BE REMOVED (SILTATION FENCES AND POSTS, DIVERSIONS AND SEDIMENT STRUCTURES, ETC.)
- ALL DELIVERABLES (CERTIFICATIONS, SURVEY INFORMATION, AS-BUILT PLANS, REPORTS, NOTICES OF TERMINATION, ETC.) IN ACCORDANCE WITH ALL PERMIT REQUIREMENTS SHALL BE SUBMITTED TO THE TOWN, THE MAINE DEP, HOMEOWNER'S ASSOCIATION, OWNER, AND/OR ALL APPROPRIATE ENTITIES.

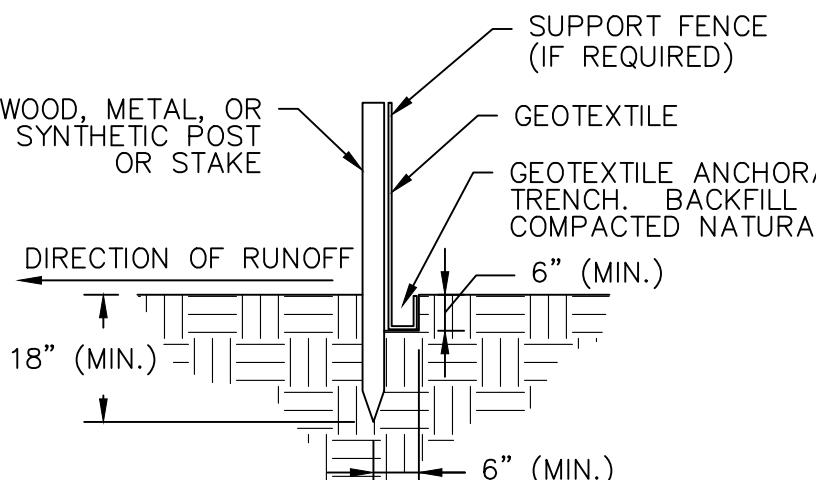


TOP VIEW (CONNECTION)


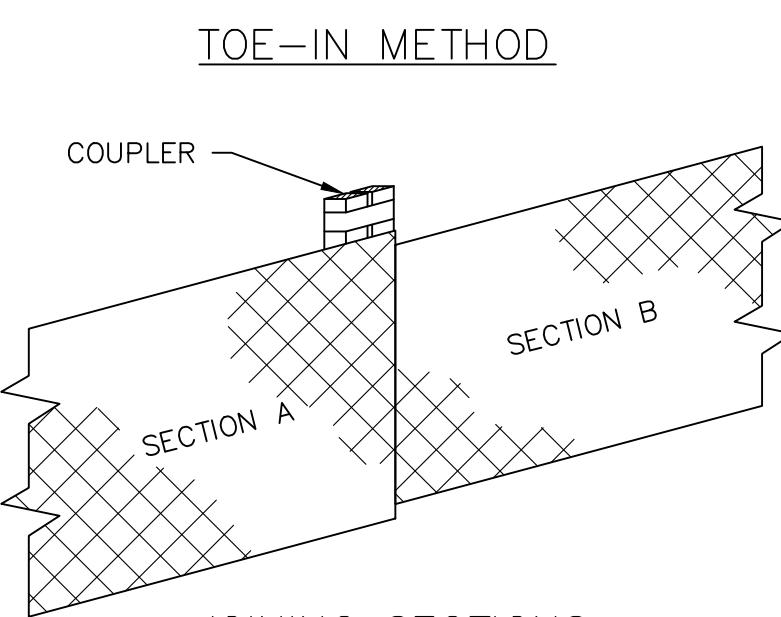


NOTES:


1. DEPENDING UPON THE CONFIGURATION, ATTACH GEOTEXTILE TO WIRE MESH WITH HOG RINGS, TO STEEL POSTS WITH TIE WIRES, AND TO WOOD POSTS WITH STAPLES.
2. POSTS MAY BE WIRED TOGETHER WHEN JOINING SECTIONS.

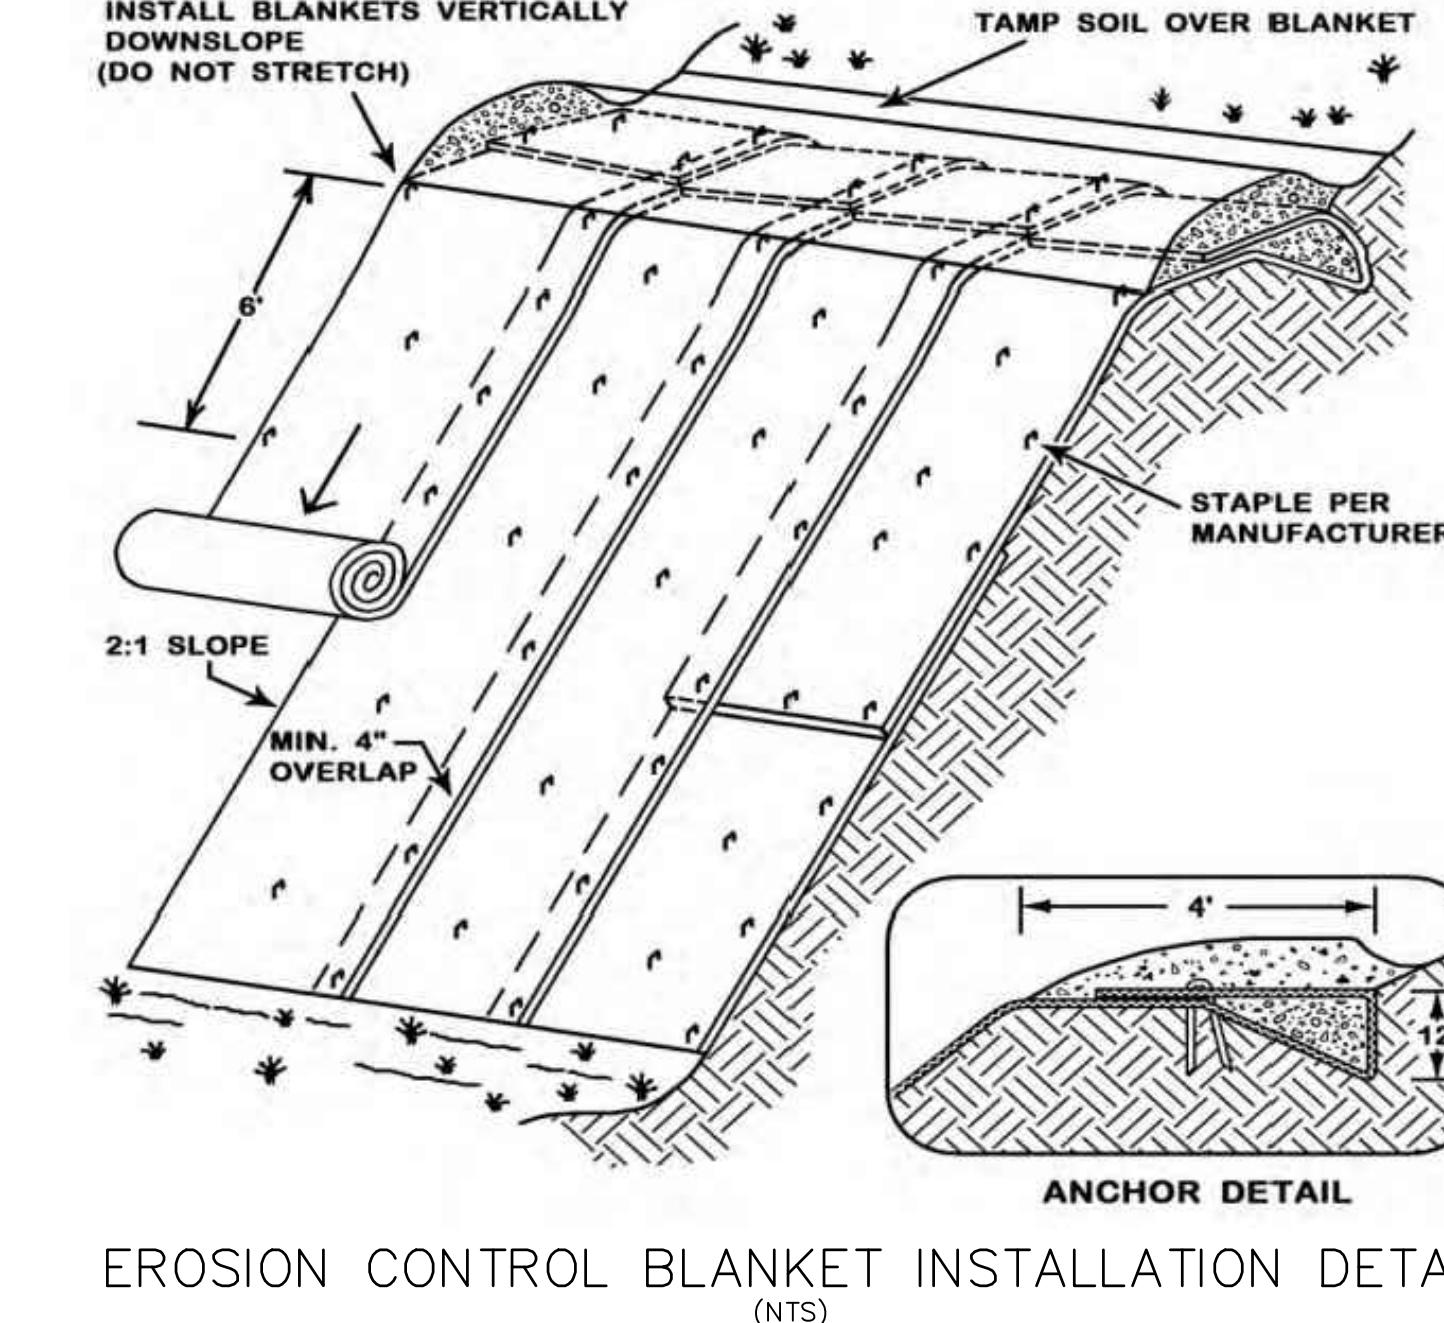

EROSION CONTROL BLANKET INSTALLATION DETAIL (NTS)

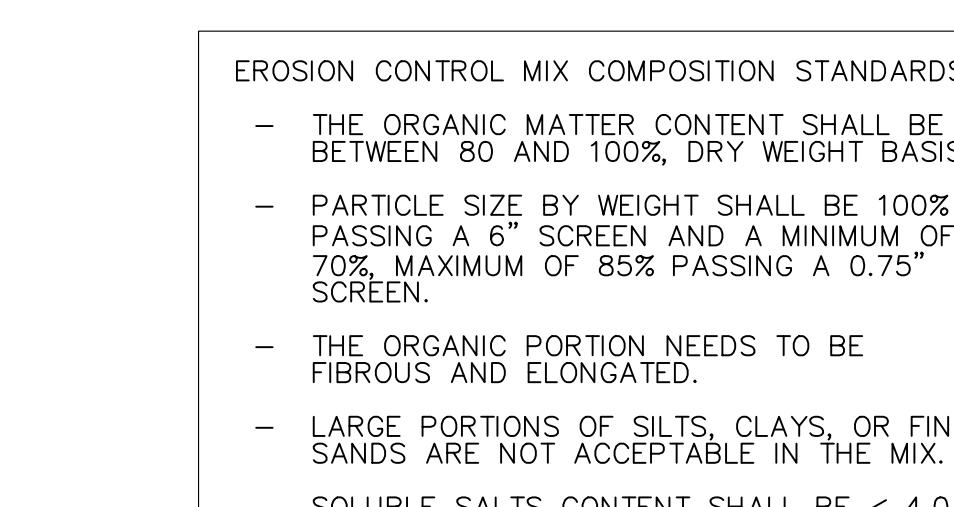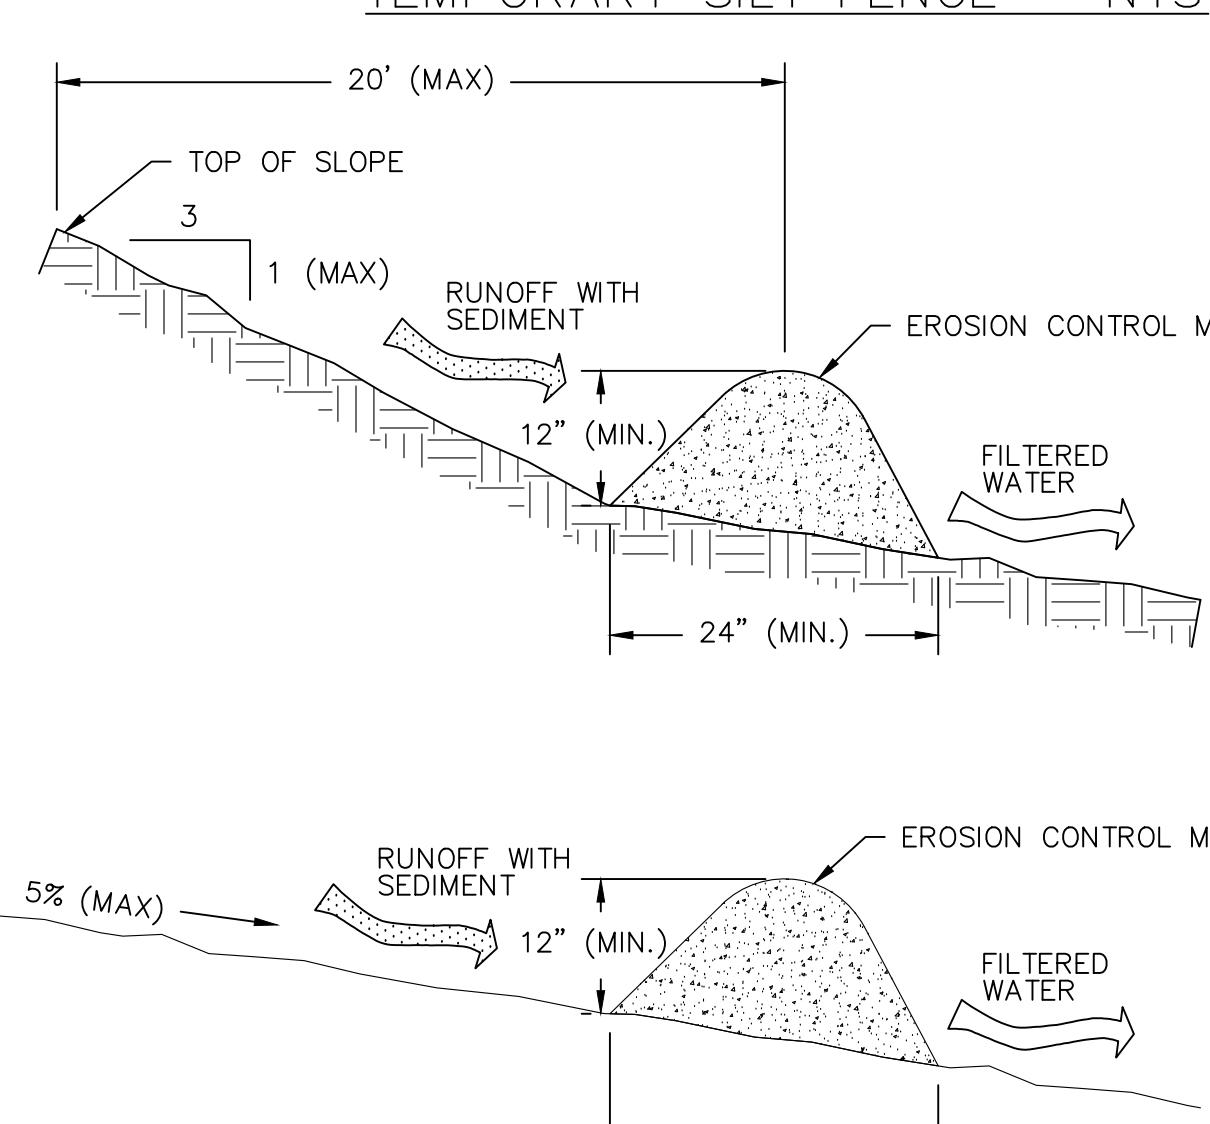



EROSION CONTROL MIX BERM - NTS

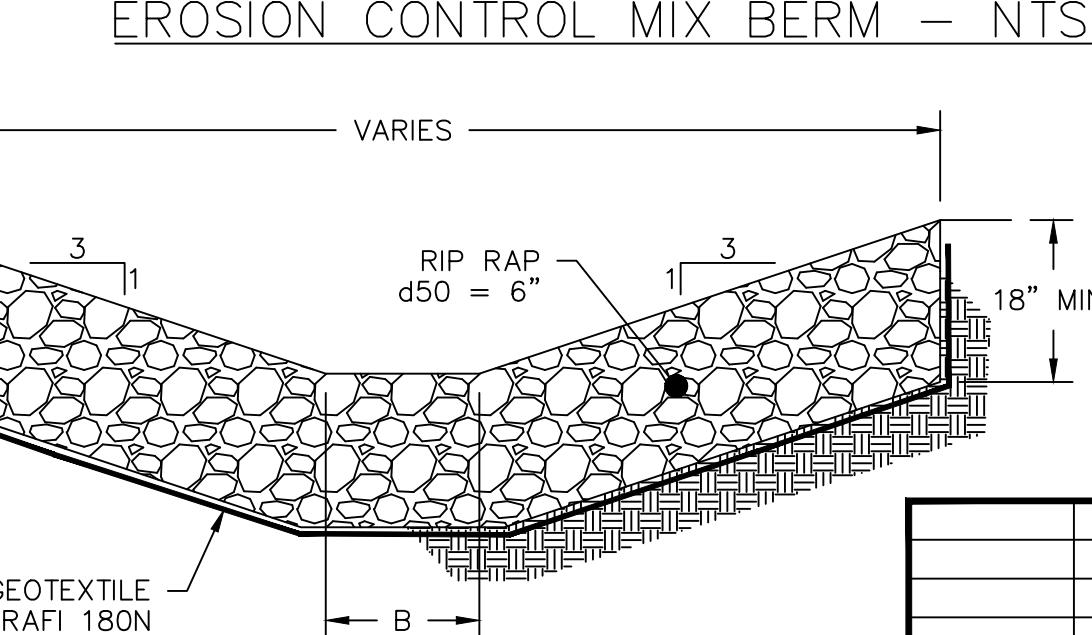


RIP RAP SWALE DETAIL

APPROVAL OF THE TOWN OF YORK PLANNING BOARD	
DATE	TAX MAP 50, LOT 122
CHAIR	
EROSION & SEDIMENTATION CONTROL DETAILS CARRIAGE LANDING - BRISTOL POINTE #2 294 YORK STREET, YORK, MAINE	
FOR: GRAYSTONE BUILDERS, INC. C/O WALTER WOODS, 764 U.S. ROUTE 1, SUITE #11 YORK, ME 03909	
ATTAR ENGINEERING, INC. CIVIL • STRUCTURAL • MARINE • SURVEYING 1284 STATE ROAD - ELIOT, MAINE 03903 PHONE: (207)439-6023 FAX: (207)439-2128	
SCALE: AS NOTED	APPROVED BY: MJS
DATE: 01/09/2026	REVISION DATE: - : -
JOB NO: 24008 FILE: 294 YORK ST BASE.DWG SHEET: 4	

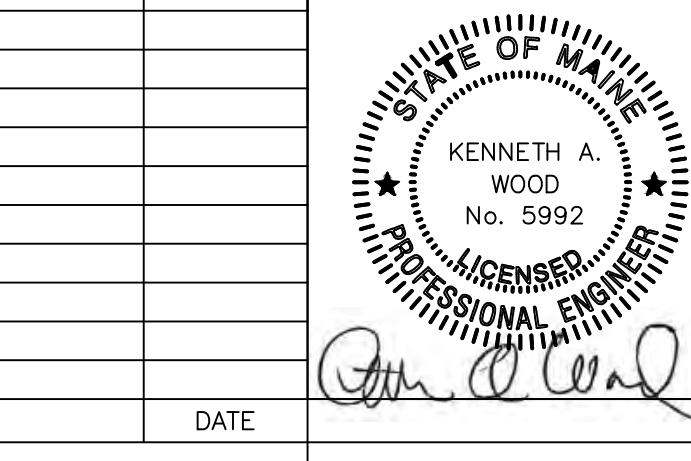


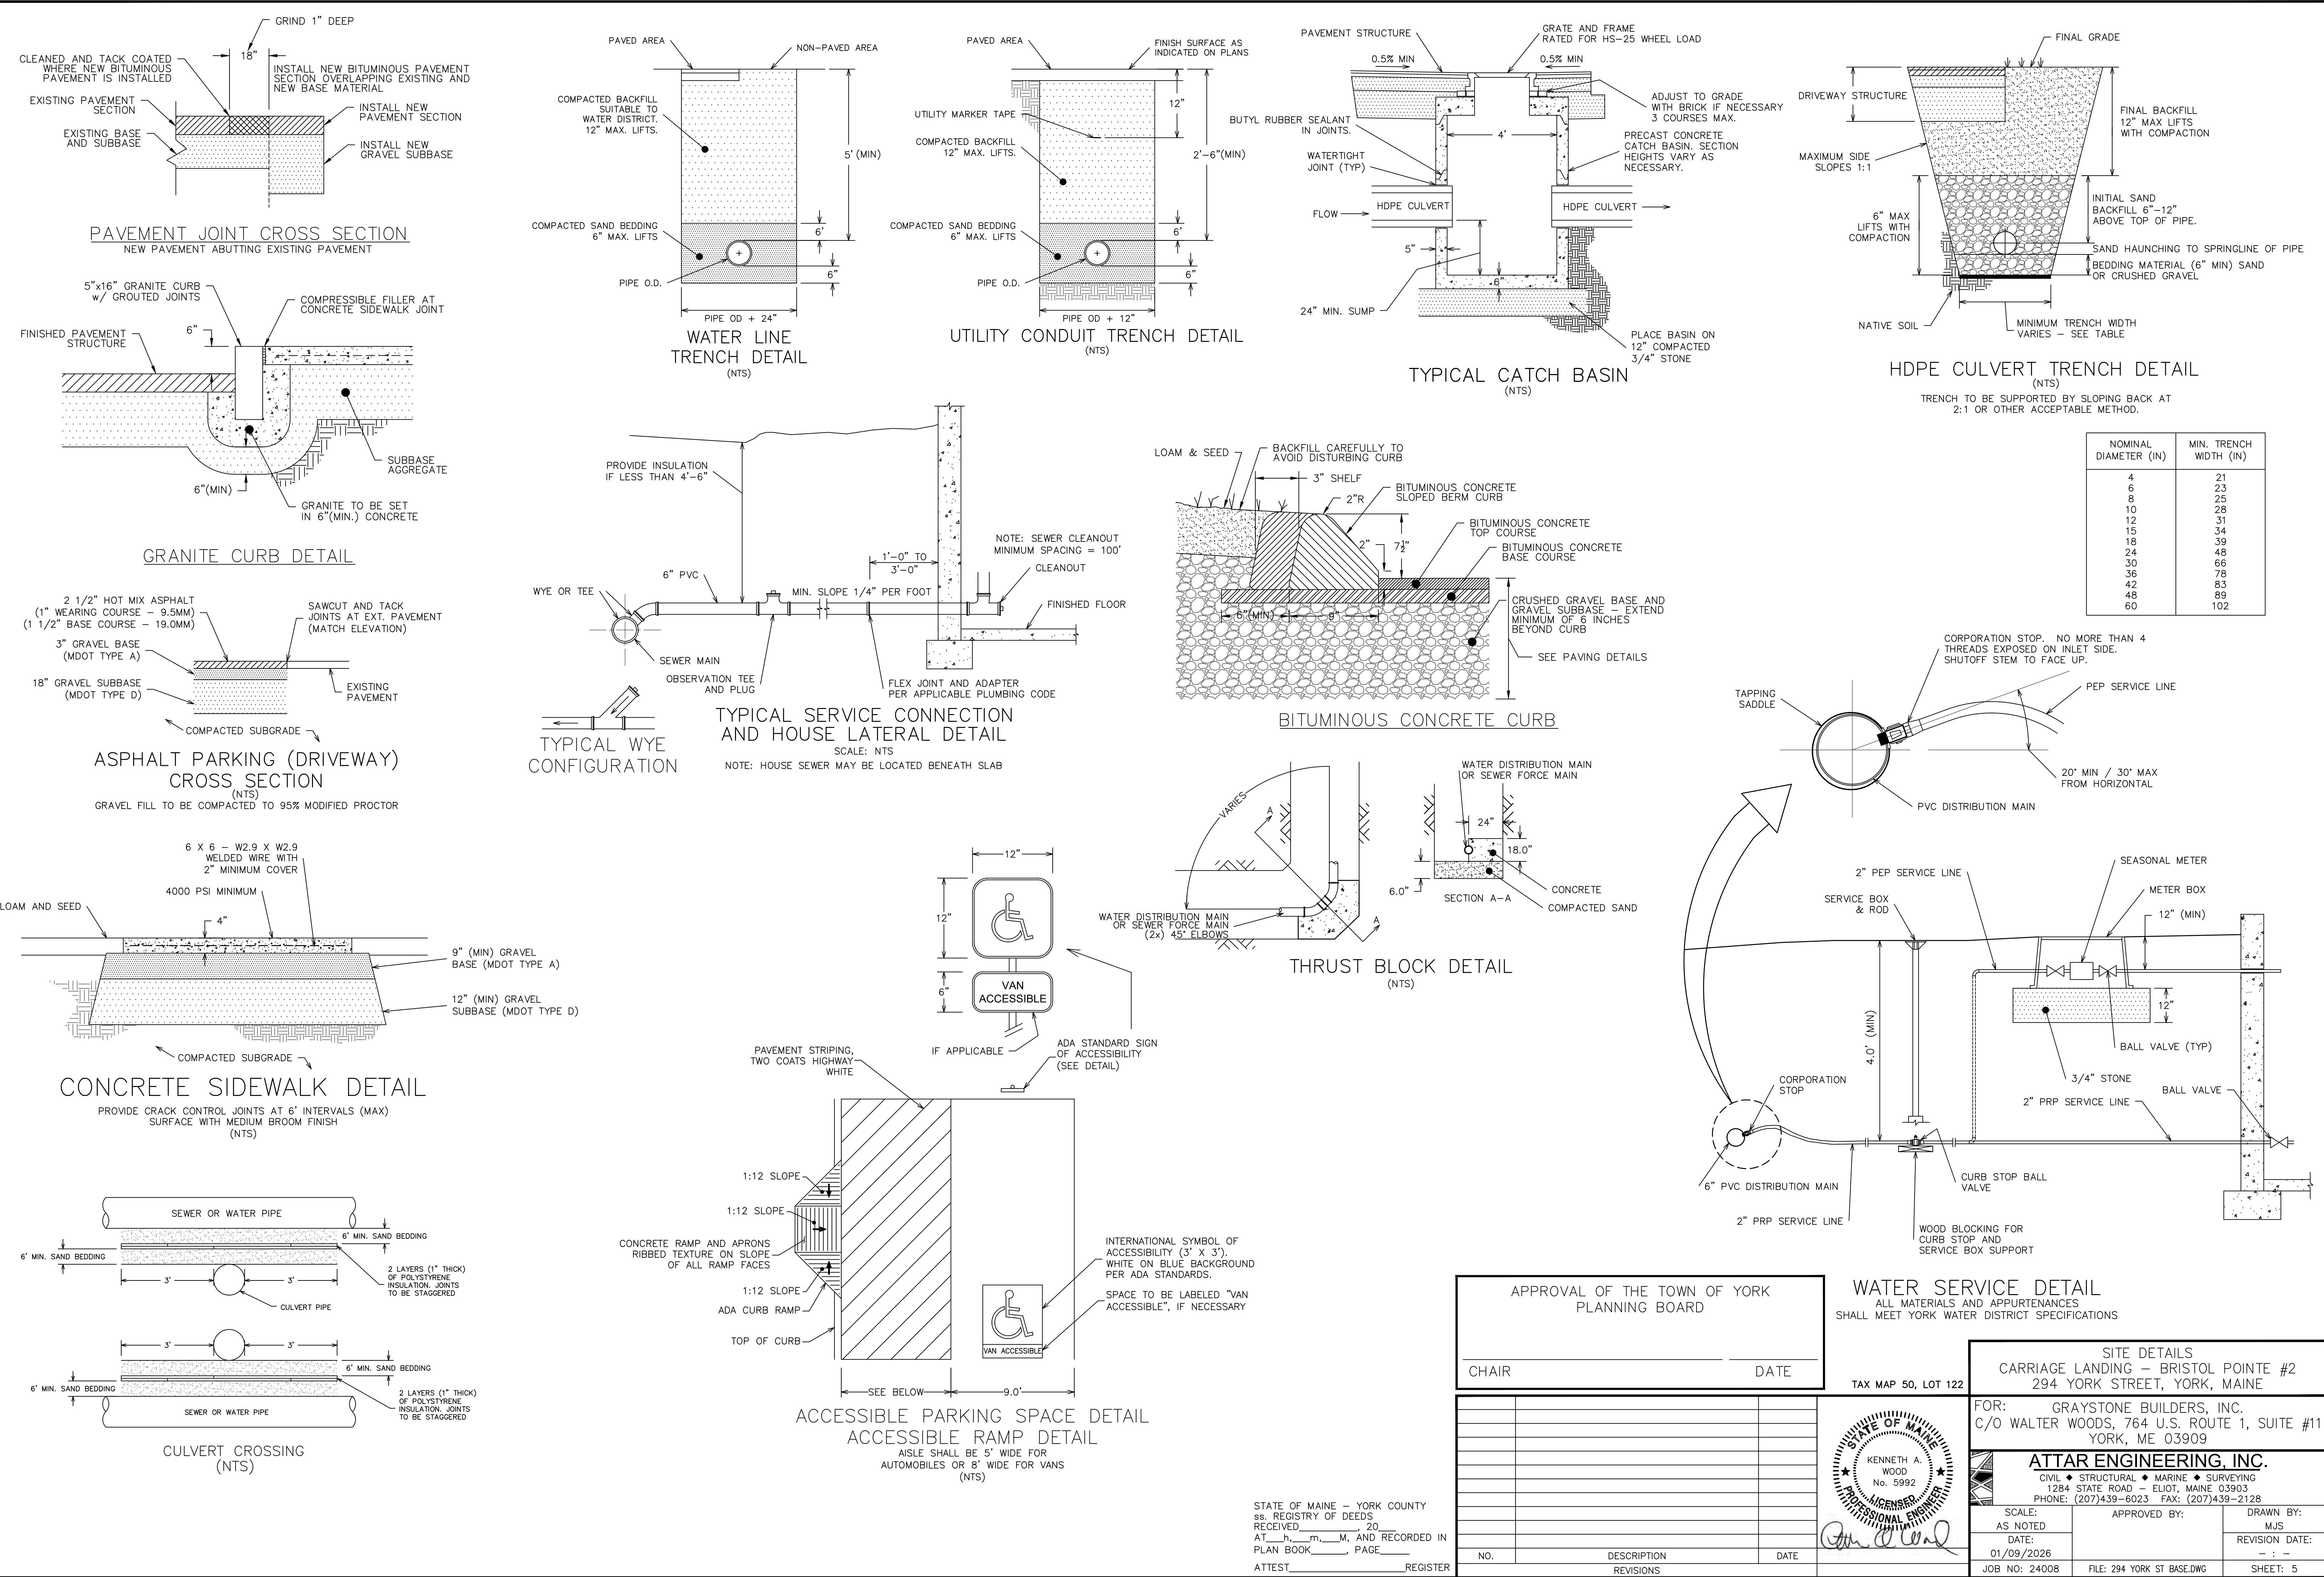

JELLYFISH DESIGN NOTES

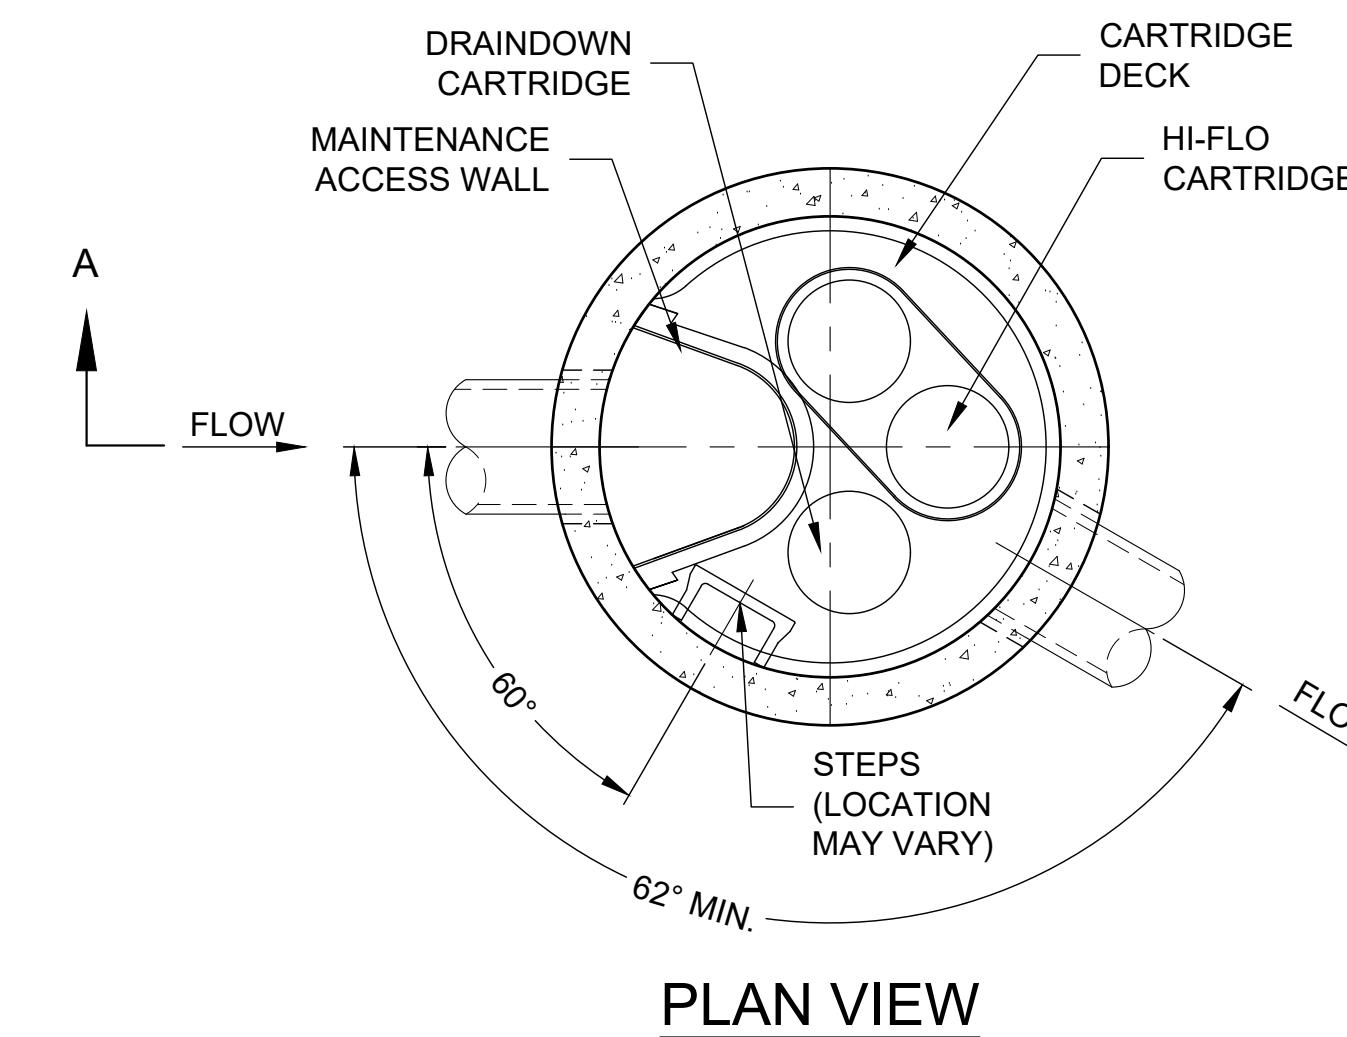

PLAN VIEW

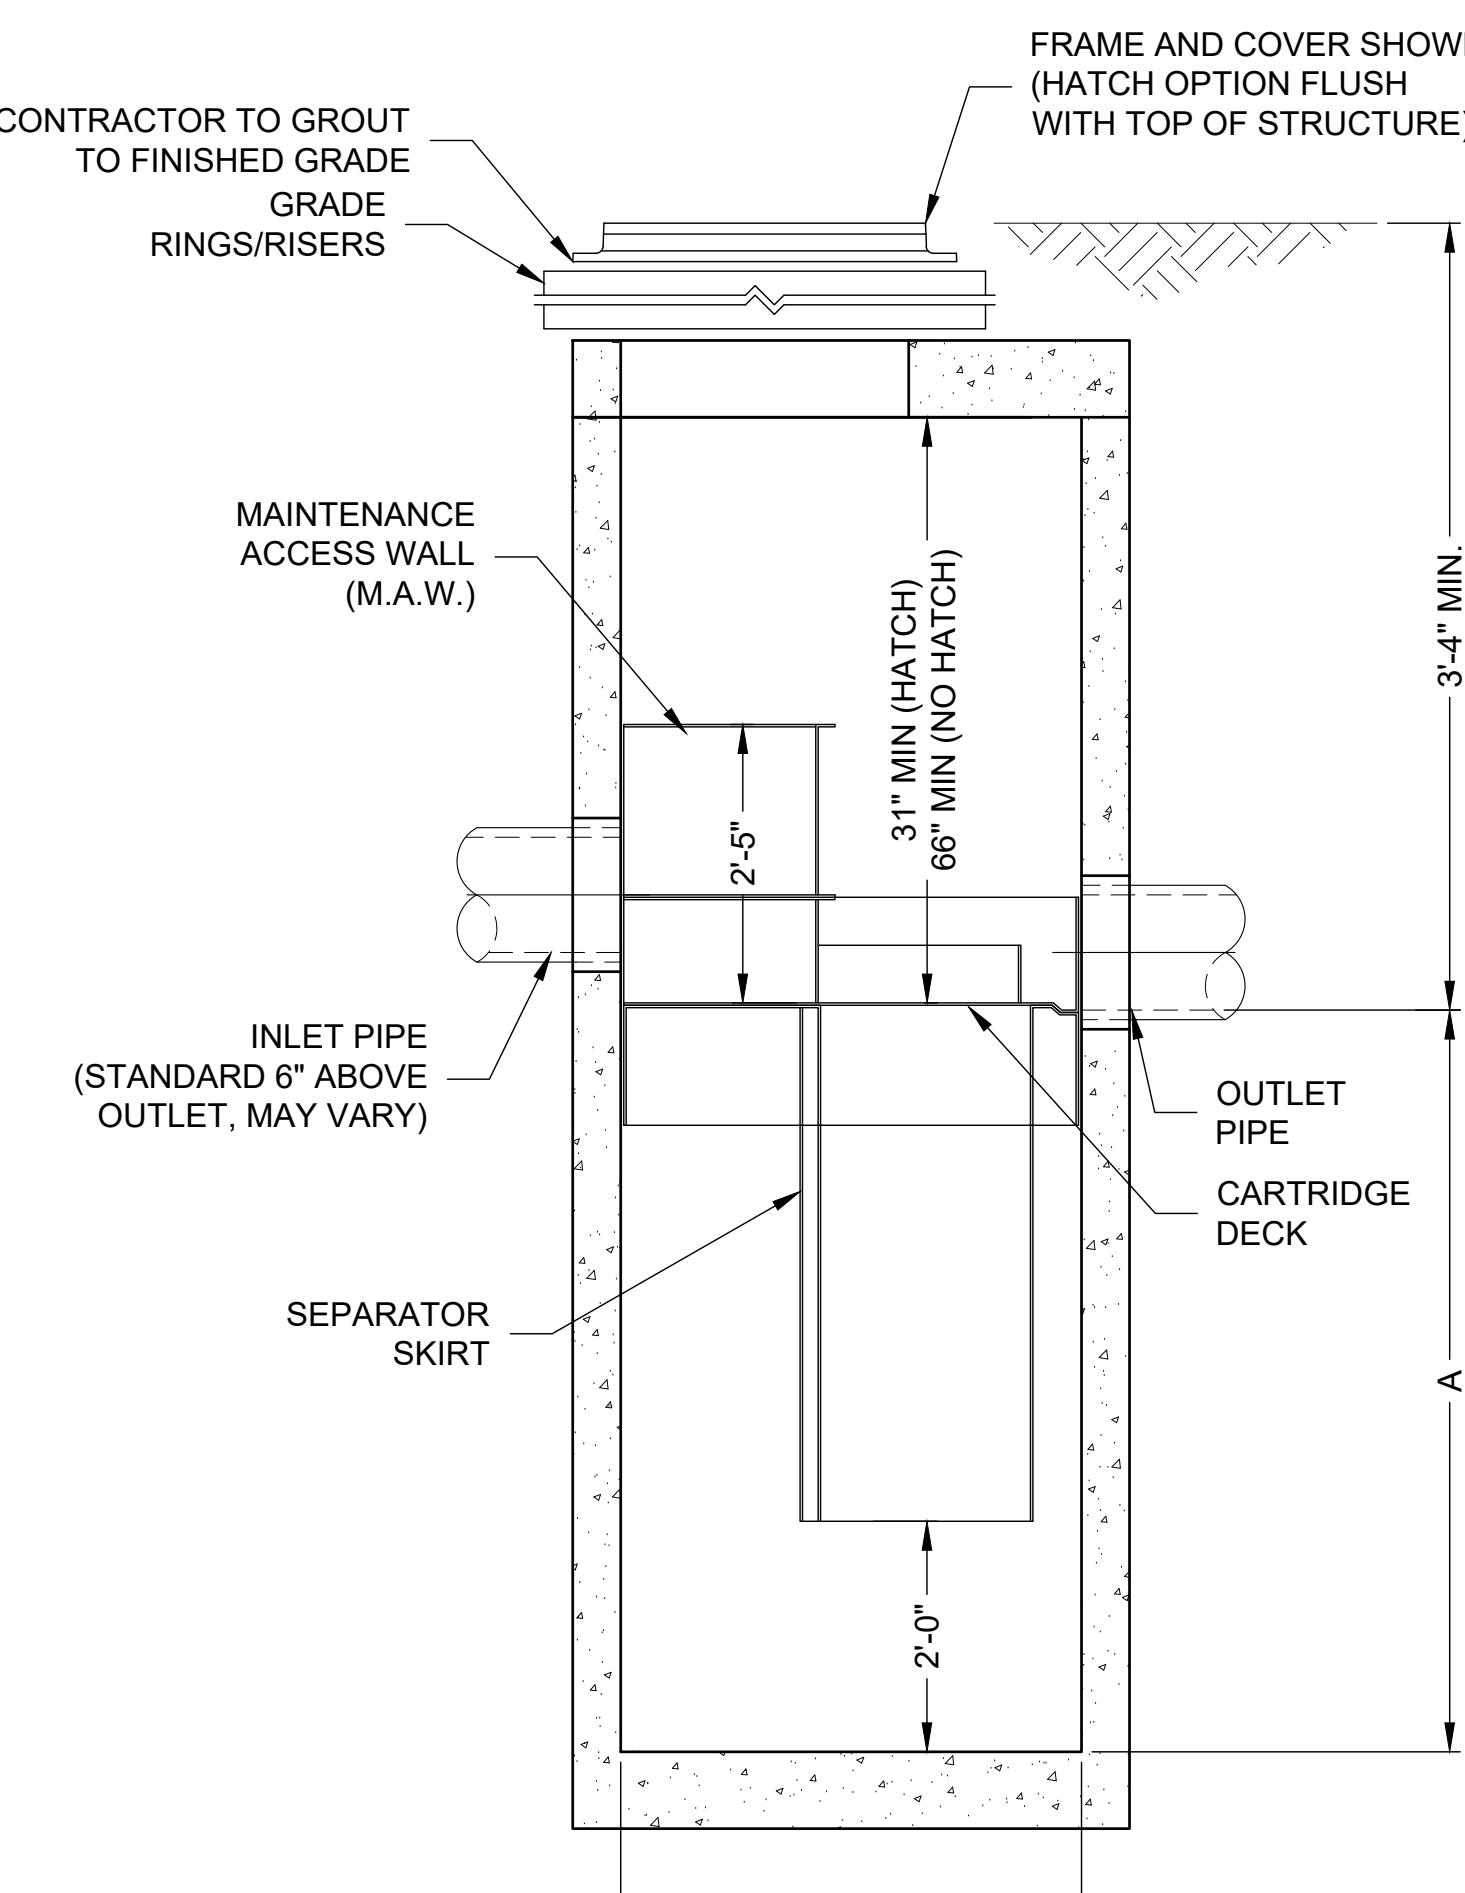

SECTION A-A



GENERAL NOTES:

1. CONTECH TO PROVIDE ALL MATERIALS UNLESS NOTED OTHERWISE.
2. FOR SITE SPECIFIC DRAWINGS WITH DETAILED STRUCTURE DIMENSIONS AND WEIGHT, PLEASE CONTACT YOUR CONTECH ENGINEERED SOLUTIONS REPRESENTATIVE. www.ContechES.com
3. JELLYFISH WATER QUALITY STRUCTURE SHALL BE IN ACCORDANCE WITH ALL DESIGN DATA AND INFORMATION CONTAINED IN THIS DRAWING. CONTRACTOR TO CONFIRM STRUCTURE MEETS REQUIREMENTS OF PROJECT.
4. STRUCTURE SHALL MEET AASHTO HS-20 OR PER APPROVING JURISDICTION REQUIREMENTS, WHICHEVER IS MORE STRINGENT, ASSUMING EARTH COVER OF 0'-3', AND GROUNDWATER ELEVATION AT, OR BELOW, THE OUTLET PIPE INVERT ELEVATION. ENGINEER OF RECORD TO CONFIRM ACTUAL GROUNDWATER ELEVATION. CASTINGS SHALL MEET AASHTO M306 LOAD RATING AND BE CAST WITH THE CONTECH LOGO.
5. STRUCTURE SHALL BE PRECAST CONCRETE CONFORMING TO ASTM C-478 AND AASHTO LOAD FACTOR DESIGN METHOD.
6. NO PRODUCT SUBSTITUTIONS SHALL BE ACCEPTED UNLESS SUBMITTED 10 DAYS PRIOR TO PROJECT BID DATE, OR AS DIRECTED BY THE ENGINEER OF RECORD.

INSTALLATION NOTES

- A. ANY SUB-BASE, BACKFILL DEPTH, AND/OR ANTI-FLOTATION PROVISIONS ARE SITE-SPECIFIC DESIGN CONSIDERATIONS AND SHALL BE SPECIFIED BY ENGINEER OF RECORD.
- B. CONTRACTOR TO PROVIDE EQUIPMENT WITH SUFFICIENT LIFTING AND REACH CAPACITY TO LIFT AND SET THE STRUCTURE (LIFTING CLUTCHES PROVIDED).
- C. CONTRACTOR WILL INSTALL AND LEVEL THE STRUCTURE, SEALING THE JOINTS, LINE ENTRY AND EXIT POINTS (NON-SHRINK GROUT WITH APPROVED WATERSTOP OR FLEXIBLE BOOT).
- D. CONTRACTOR TO TAKE APPROPRIATE MEASURES TO PROTECT CARTRIDGES FROM CONSTRUCTION-RELATED EROSION RUNOFF.
- E. CARTRIDGE INSTALLATION, BY CONTECH, SHALL OCCUR ONLY AFTER SITE HAS BEEN STABILIZED AND THE JELLYFISH UNIT IS CLEAN AND FREE OF DEBRIS. CONTACT CONTECH TO COORDINATE CARTRIDGE INSTALLATION WITH SITE STABILIZATION AT (866) 740-3318.

JELLYFISH TREATMENT CAPACITY IS A FUNCTION OF THE CARTRIDGE SELECTION AND THE NUMBER OF CARTRIDGES. THE STANDARD MANHOLE STYLE IS SHOWN. Ø48" MANHOLE JELLYFISH PEAK TREATMENT CAPACITY IS 0.45 CFS. IF THE SITE CONDITIONS EXCEED 0.45 CFS AN UPSTREAM BYPASS STRUCTURE IS REQUIRED.				
CARTRIDGE SELECTION				
CARTRIDGE DEPTH	54"	40"	27"	15"
OUTLET INVERT TO STRUCTURE INVERT (A)	6'-5"	5'-3"	4'-2"	3'-2"
FLOW RATE HIGH-FLO / DRAINDOWN (cfs) (per cart)	0.18 / 0.09	0.13 / 0.065	0.09 / 0.045	0.05 / 0.025
MAX. CARTS HIGH-FLO / DRAINDOWN	2 / 1			

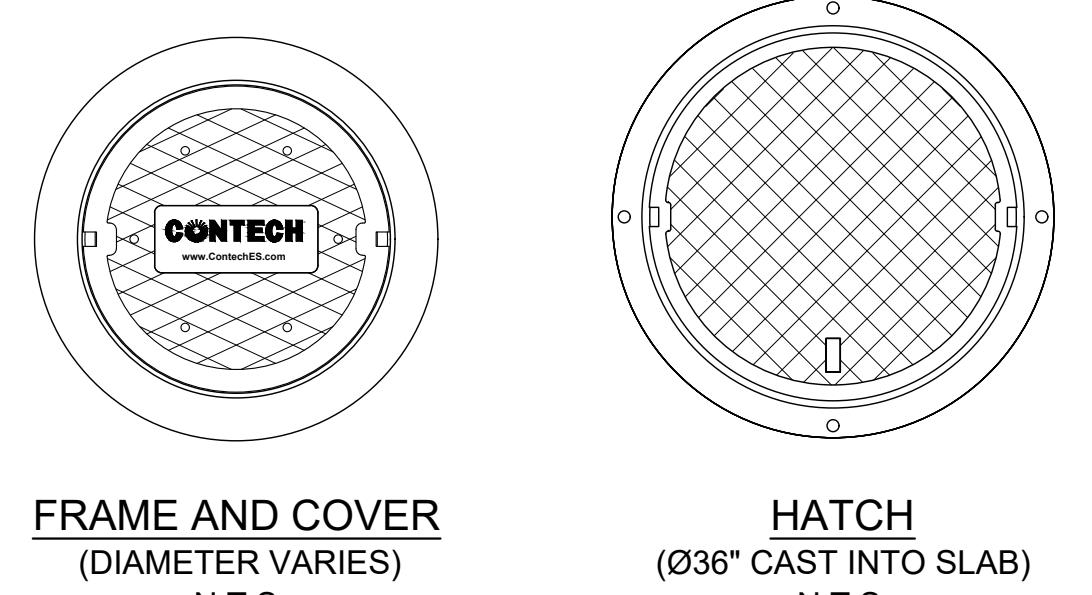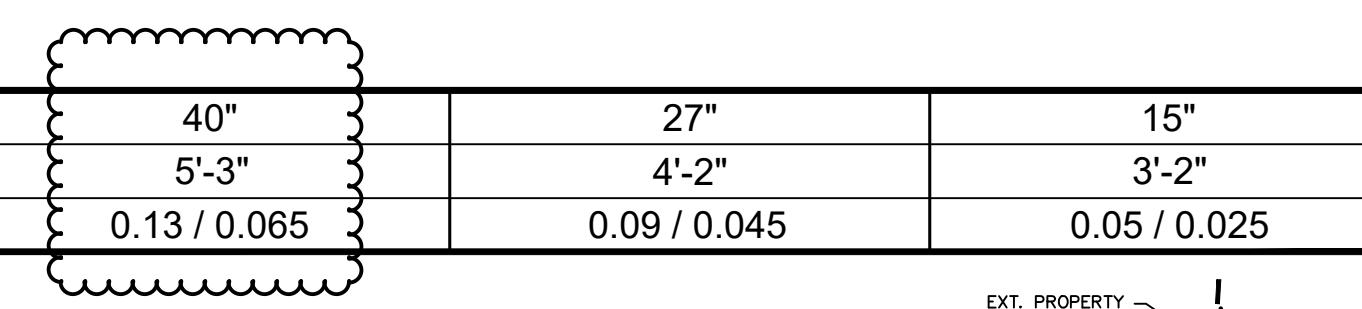

APPROVAL OF THE TOWN OF YORK PLANNING BOARD	
CHAIR	DATE

STATE OF MAINE - YORK COUNTY
ss. REGISTRY OF DEEDS
RECEIVED _____, 20
AT _____, M, AND RECORDED IN
PLAN BOOK _____, PAGE _____
ATTEST _____ REGISTER

RECEIVED _____, 20
AT _____, M, AND RECORDED IN
PLAN BOOK _____, PAGE _____
ATTEST _____ REGISTER




THIS PLAN IS AN AMENDMENT TO REFERENCE PLAN NO. #
'OVERALL SITE PLAN AMENDMENT, CARRIAGE LANDING - BRISTOL
POINTE NO. 2, 294 YORK STREET, YORK, MAINE' APPROVED BY THE
TOWN OF YORK PLANNING BOARD ON JUNE 17, 2025. THE
PROPOSED AMENDMENT INCLUDES ADDITIONAL REARYARD
PARKING AND CHANGES TO ON-SITE STORMWATER MANAGEMENT
RELATED TO THE EXISTING MUNICIPAL DRAINAGE EASEMENT.

STORMWATER: EXISTING CONDITIONS
CARRIAGE LANDING - BRISTOL POINTE #2
294 YORK STREET, YORK, MAINE

TAX MAP 50, LOT 122

FOR: GRAYSTONE BUILDERS, INC.
C/O WALTER WOODS, 764 U.S. ROUTE 1, SUITE #11
YORK, ME 03909

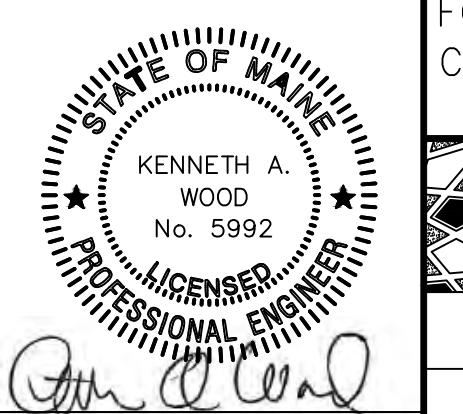


ATTAR ENGINEERING, INC.
CIVIL • STRUCTURAL • MARINE • SURVEYING
1284 STATE ROAD - ELIOT, MAINE 03903
PHONE: (207)439-6023 FAX: (207)439-2128

SCALE: 1" = 20'	APPROVED BY: MJS
DATE: 01/09/2026	REVISION DATE: --
JOB NO: 24008	FILE: 294 YORK ST BASE.DWG
SHEET: 7	


APPROVAL OF THE TOWN OF YORK PLANNING BOARD	
CHAIR	DATE

STATE OF MAINE - YORK COUNTY
ss. REGISTRY OF DEEDS
RECEIVED, 20
AT h m, M, AND RECORDED IN
PLAN BOOK PAGE
ATTEST REGISTER

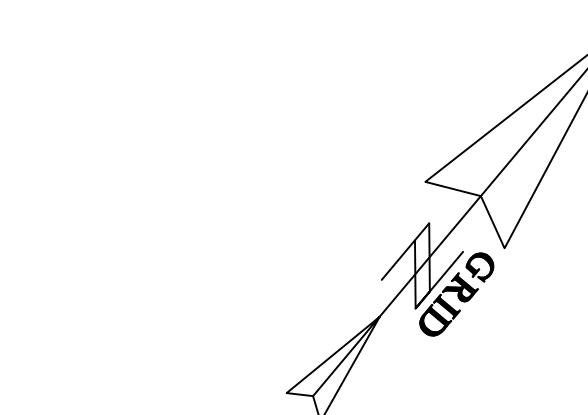

GRAPHIC SCALE
0 20 40 60 80 (FEET)

NO.	DESCRIPTION	DATE
	REVISIONS	

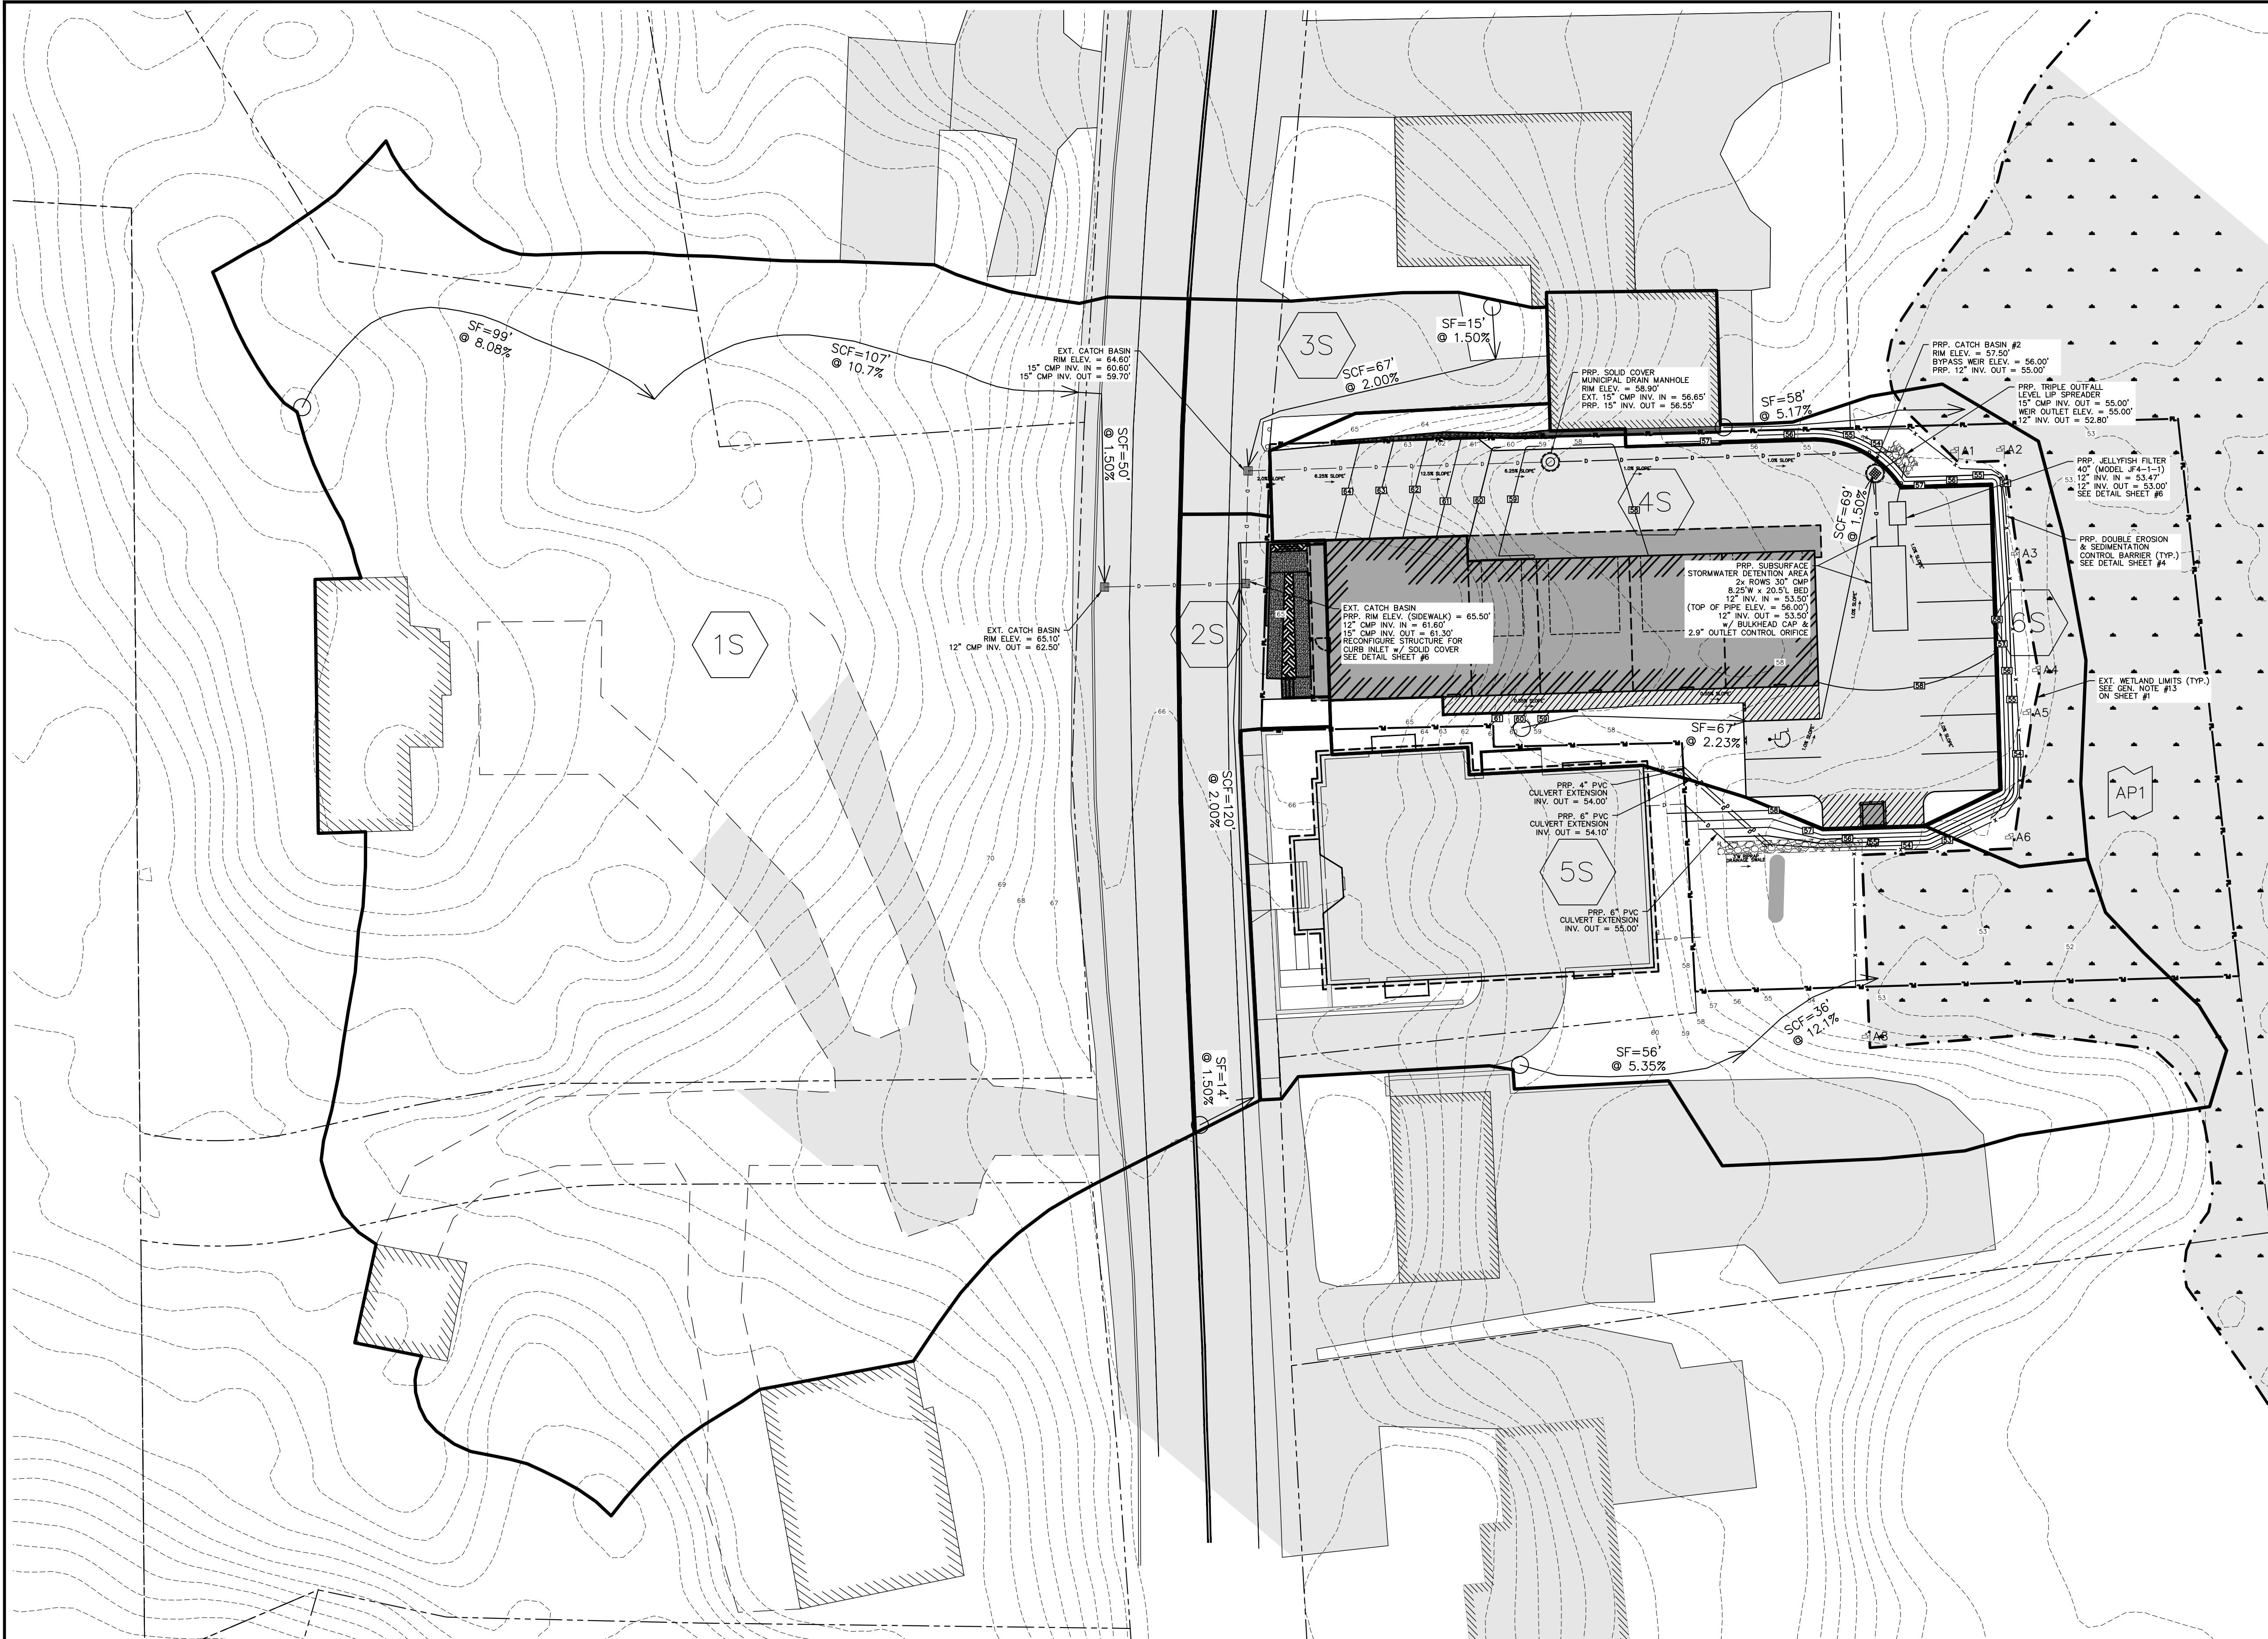

SUBCATCHMENT
 REACH
 POND (LEVEL SPREADER)
 ANALYSIS POINT

LEGEND	
PROPERTY LINE	
EXT. BUILDING	
PRP. BUILDING	
EXT. PAVEMENT	
EXT. GRAVEL	
PRP. PAVEMENT	
EXT. STORM LINE	
PRP. STORM LINE	
EXT. CATCH BASIN	
PRP. CATCH BASIN	
EXT. MAJOR CONTOUR	
EXT. MINOR CONTOUR	
PRP. MAJOR CONTOUR	
PRP. MINOR CONTOUR	
EXT. WETLAND BNDY	
EXT. WETLAND AREA	
PRP. SUBCATCHMENT	
PRP. Tc FLOW LINE	
PRP. Tc GRADE CALC	

THIS PLAN IS AN AMENDMENT TO REFERENCE PLAN NO. #
 'OVERALL SITE PLAN AMENDMENT, CARRIAGE LANDING - BRISTOL
 POINTE NO. 2, 294 YORK STREET, YORK, MAINE' APPROVED BY THE
 TOWN OF YORK PLANNING BOARD ON JUNE 17, 2025. THE
 PROPOSED AMENDMENT INCLUDES ADDITIONAL REARWARD
 PARKING AND CHANGES TO ON-SITE STORMWATER MANAGEMENT
 RELATED TO THE EXISTING MUNICIPAL DRAINAGE EASEMENT.


STORMWATER: DEVELOPED CONDITIONS
 CARRIAGE LANDING - BRISTOL POINTE #2
 294 YORK STREET, YORK, MAINE

TAX MAP 50, LOT 122


FOR: GRAYSTONE BUILDERS, INC. C/O WALTER WOODS, 764 U.S. ROUTE 1, SUITE #11 YORK, ME 03909	
ATTAR ENGINEERING, INC.	
CIVIL • STRUCTURAL • MARINE • SURVEYING	
128A STATE ROAD — ELIOT, MAINE 03903	
PHONE: (207)439-6023 FAX: (207)439-2128	
SCALE: 1" = 20'	APPROVED BY: MJS
DATE: 01/09/2026	REVISION DATE: A : 01/22/26
JOB NO: 24008 FILE: 294 YORK ST BASE.DWG SHEET: 8	


APPROVAL OF THE TOWN OF YORK PLANNING BOARD	
CHAIR	DATE

STATE OF MAINE - YORK COUNTY
 ss. REGISTRY OF DEEDS
 RECEIVED 20, 20
 AT h m, M, AND RECORDED IN
 PLAN BOOK PAGE
 ATTEST REGISTER

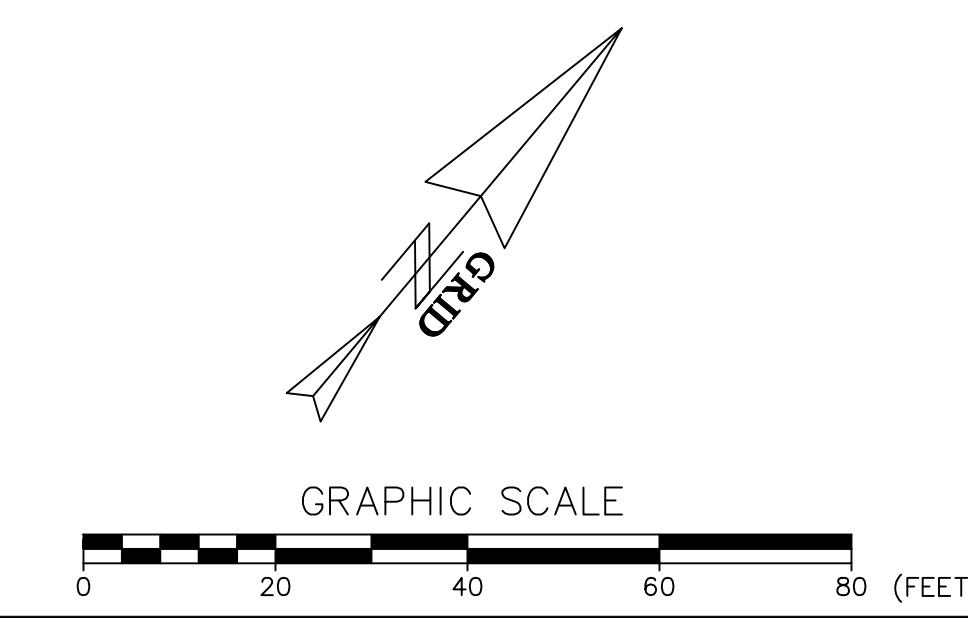

A	AMENDMENT REVISIONS - PROPANE TANK	01/22/26
NO.	DESCRIPTION	DATE
	REVISIONS	

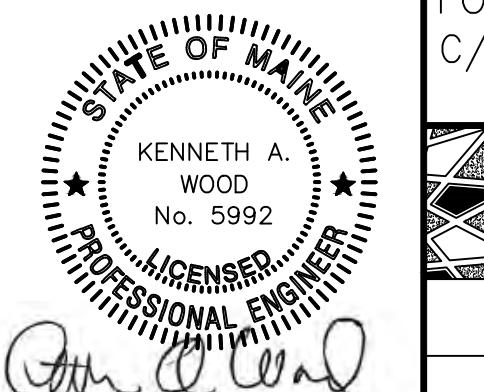

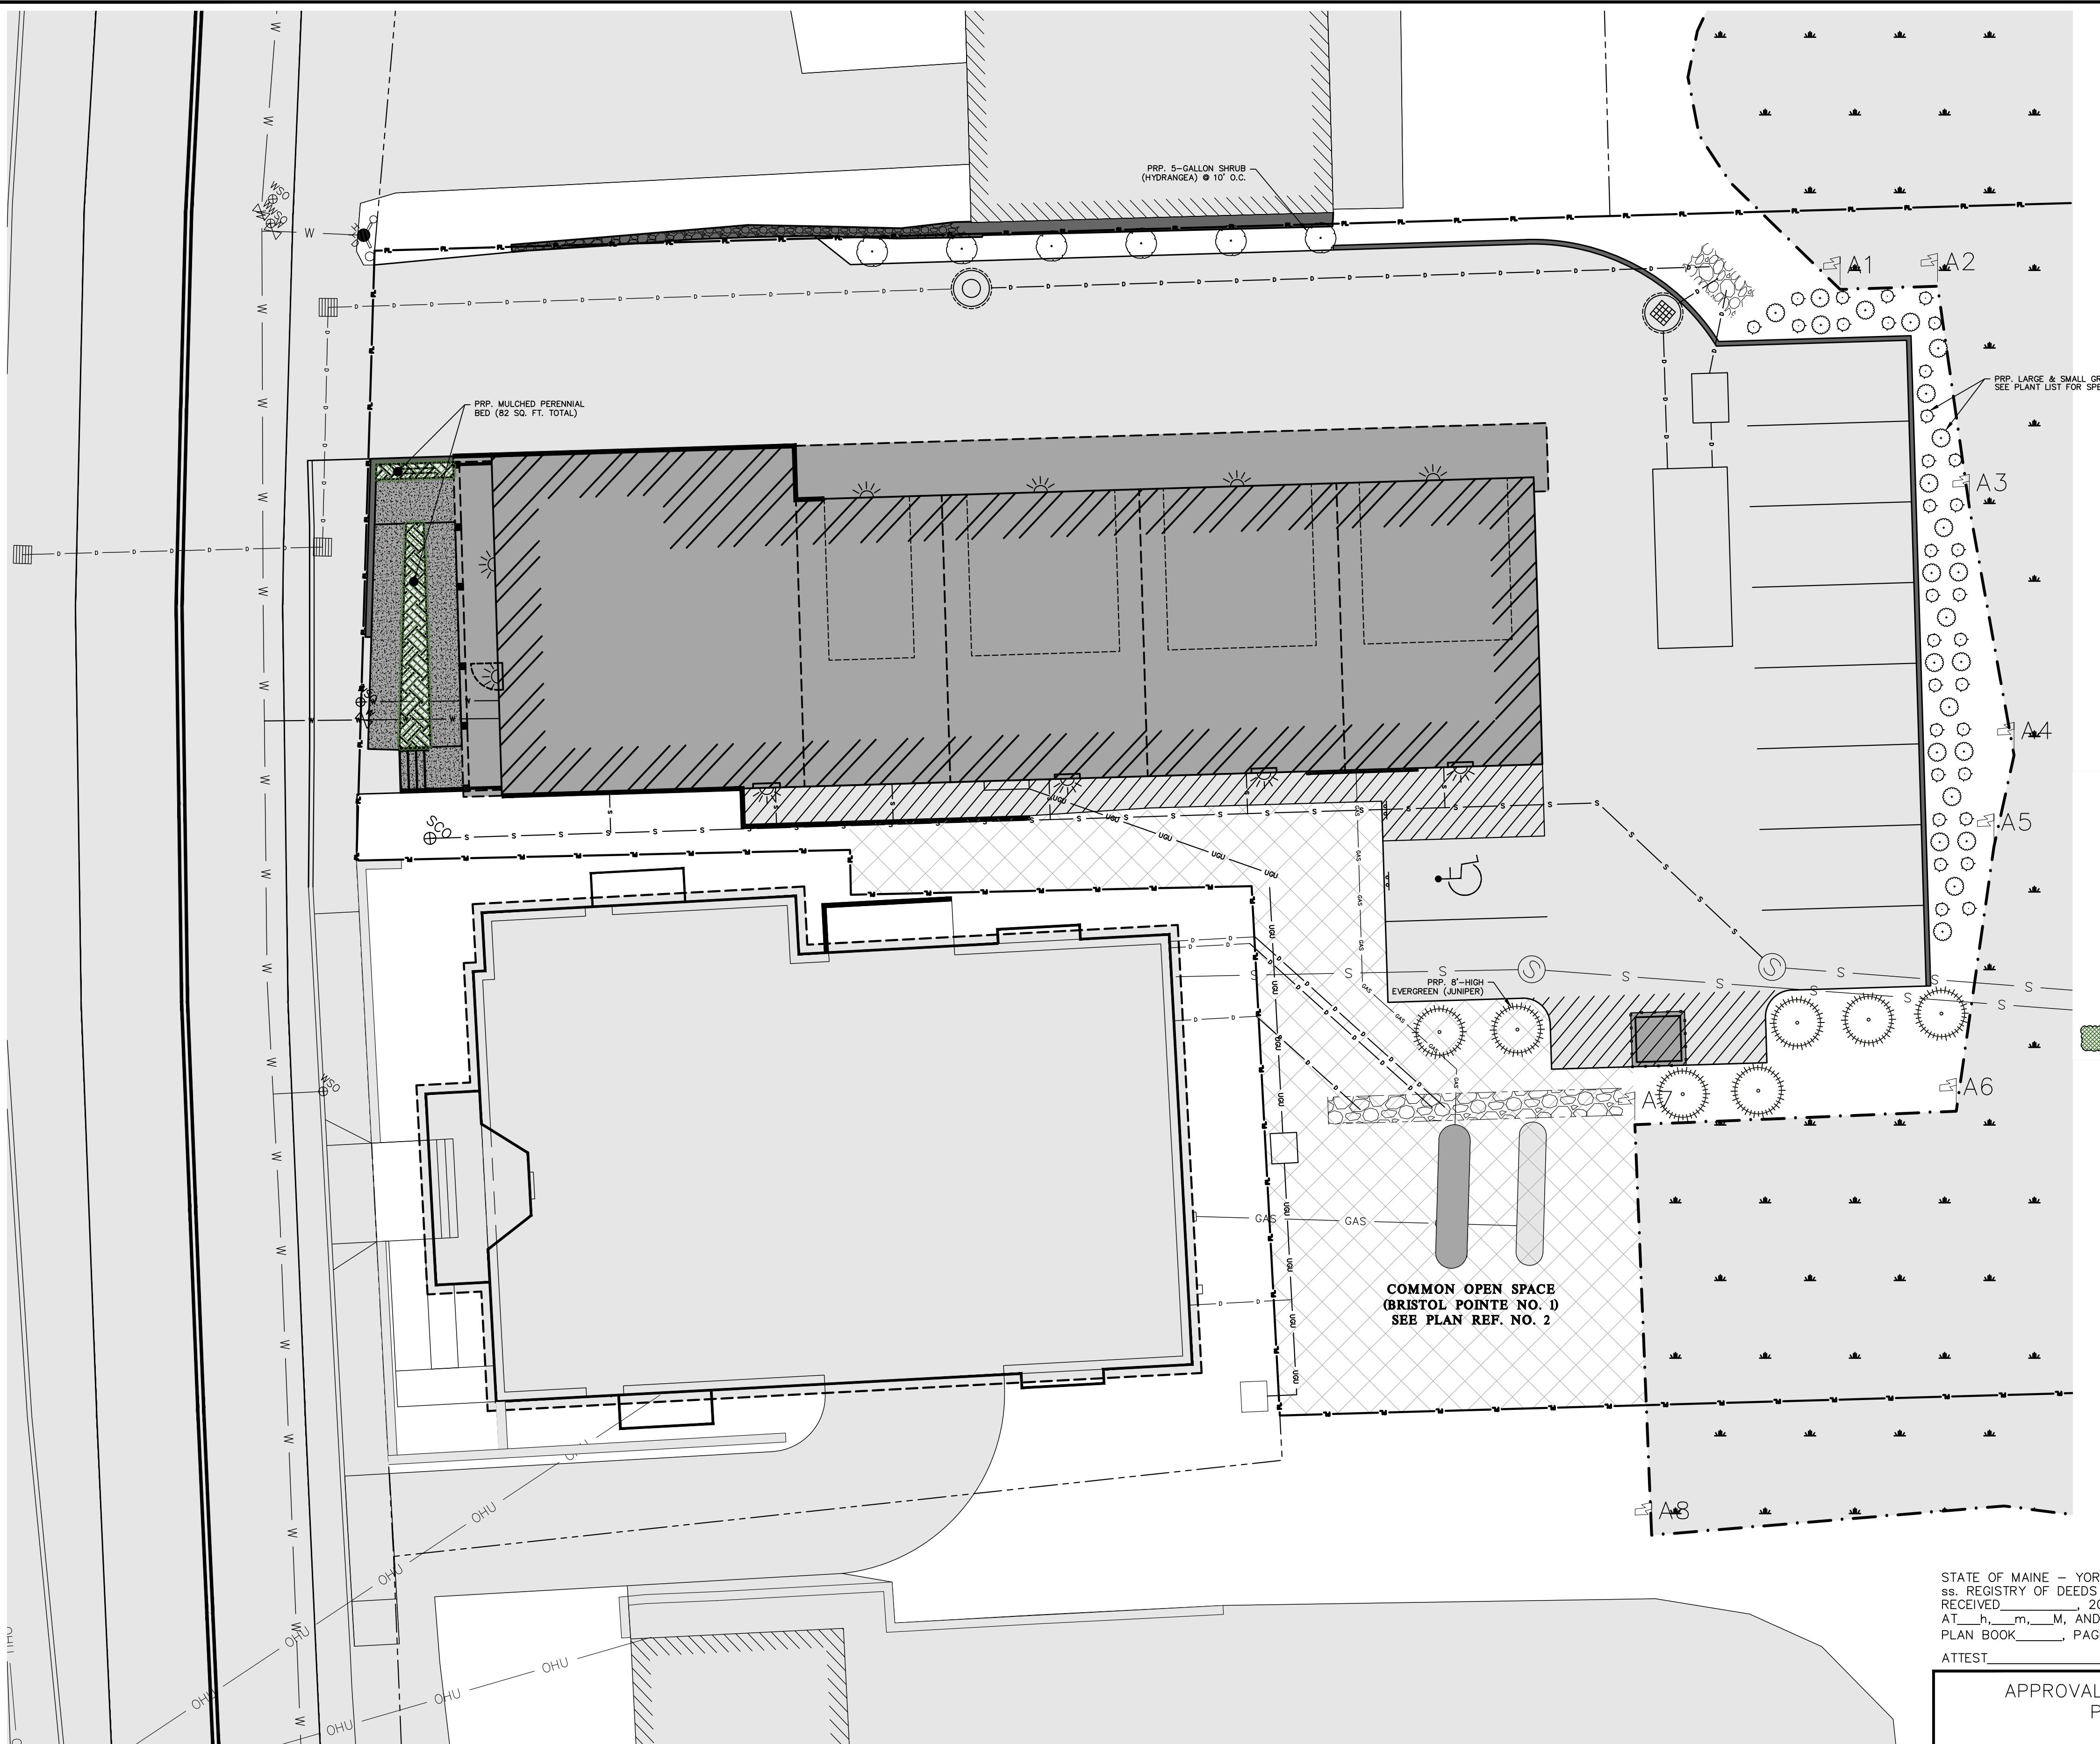

PLANT LIST

QTY	NAME	LATIN	SIZE
7	TAYLOR JUNIPER	JUNIPERUS VIRGINIANA 'TAYLOR'	12'H, 3'W
6	LIMELIGHT HYDRANGEA	HYDRANGEA 'LIMELIGHT'	5 GAL.
23	REED GRASS 'KARL FOERSTER'	MISCANthus SINensis 'KARL FOERSTER'	3 GAL.
33	DWARF FOUNTAIN GRASS 'HAMELN'	PENNSETUM ALOPECUROIDES	3 GAL.
82	ASSORTED PERENNIALS	DAYLILY, SEDUM, LAVENDER, HOSTA	SQ. FT.

PLANTING NOTES:


1. THE LANDSCAPE CONTRACTOR SHALL SUPPLY ALL PLANTS IN QUANTITIES SUFFICIENT TO COMPLETE THE WORK SHOWN ON THE PLAN.
2. ANY SUBSTITUTION OF SPECIFIED PLANTS SHALL BE APPROVED BY THE LANDSCAPE ARCHITECT. ONLY NATIVE SPECIES AND/OR VARIETIES WILL BE ACCEPTABLE.
3. ALL TREE, SHRUB, VINE AND PLANT BED (GROUNDCOVERS, PERENNIALS, BULBS, ETC.) LOCATIONS SHALL BE STAKED OR MARKED BY CONTRACTOR AND THEN APPROVED BY THE LANDSCAPE ARCHITECT IN THE FIELD PRIOR TO PLANTING. CONTRACTOR MUST GIVE A MINIMUM 3 DAY NOTICE BETWEEN STAKING AND PLANTING.
4. CHALK MARK NORTH AT TREE BASE PRIOR TO DIGGING AT NURSERY. REPLANT ON SITE WITH SAME NORTH ORIENTATION FOR ALL TREES.
5. ALL PLANTS INSTALLED SHALL MEET THE SPECIFICATIONS OF THE AMERICAN STANDARD FOR NURSERY STOCK (LATEST EDITION) AS SET FORTH BY THE AMERICAN NURSERY AND LANDSCAPE ASSOCIATION.

GRAPHIC SCALE
0 10 20 30 40 (FEET)

STATE OF MAINE - YORK COUNTY
ss. REGISTRY OF DEEDS
RECEIVED _____ 20_____
AT _____ h. _____ m. AND RECORDED IN
PLAN BOOK _____ PAGE _____
ATTEST _____ REGISTER

APPROVAL OF THE TOWN OF YORK PLANNING BOARD	
CHAIR	DATE


TAX MAP 50, LOT 122			
A	AMENDMENT REVISIONS - PROPANE TANK	01/22/26	
NO.	DESCRIPTION	DATE	
	REVISIONS		

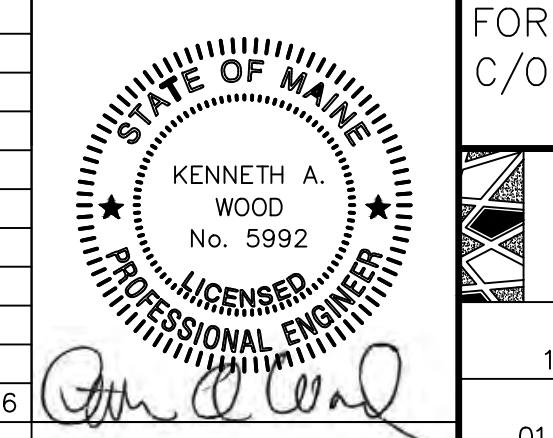

LANDSCAPING PLAN
CARRIAGE LANDING - BRISTOL POINTE #2
294 YORK STREET, YORK, MAINE

FOR: GRAYSTONE BUILDERS, INC. C/O WALTER WOODS, 764 U.S. ROUTE 1, SUITE #11 YORK, ME 03909
ATTAR ENGINEERING, INC. CIVIL • STRUCTURAL • MARINE • SURVEYING 128A STATE ROAD - ELIOT, MAINE 03903 PHONE: (207)439-6223 FAX: (207)439-2128
SCALE: 1" = 10' DATE: 01/09/2026 APPROVED BY: MJS REVISION DATE: A : 01/22/26
JOB NO: 24008 FILE: 294 YORK ST BASE.DWG SHEET: 9

1 LPI
NOT TO SCALE

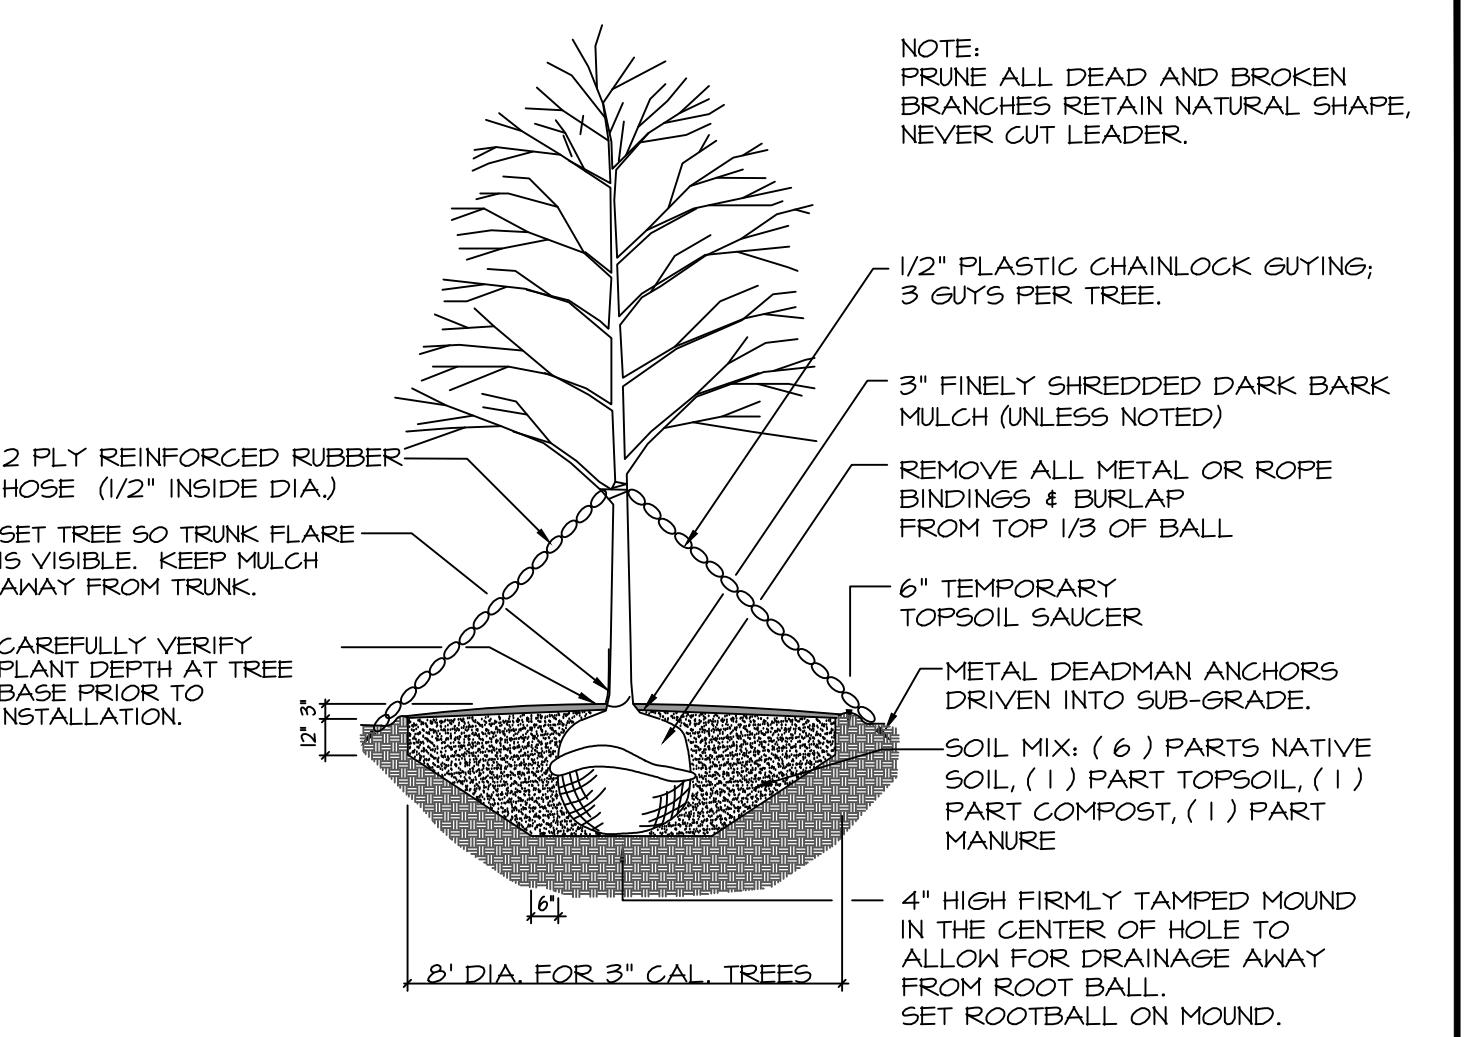


NOTE: PRUNE ALL DEAD AND BROKEN BRANCHES, RETAIN NATURAL SHAPE, NEVER CUT LEADER.
1/2" PLASTIC CHAINLOCK GUYING, 3 GUYS PER TREE.
3" FINELY SHREDDED DARK BARK MULCH (UNLESS NOTED)
REMOVE ALL METAL OR ROPE BINDINGS & BURLAP FROM TOP 1/3 OF BALL.
2 PLY REINFORCED RUBBER HOSE (1/2" INSIDE DIA.)
SET TREE SO TRUNK FLARE IS VISIBLE. KEEP MULCH AWAY FROM TRUNK.
CAREFULLY VERIFY PLANT DEPTH AT TREE BASE PRIOR TO INSTALLATION.
6" TEMPORARY TOPSOIL SAUCER
METAL DEADMAN ANCHORS DRIVEN INTO SUB-GRADE.
SOIL MIX: (6) PARTS NATIVE SOIL, (1) PART TOPSOIL, (1) PART COMPOST, (1) PART MANURE
4" HIGH FIRMLY TAMPED MOUND IN THE CENTER OF HOLE TO ALLOW FOR DRAINAGE AWAY FROM ROOT BALL. SET ROOTBALL ON MOUND.

16'
18'
12' DIA. FOR 3" CAL TREES

DECIDUOUS TREE PLANTING INSTALLATION


2 LPI
NOT TO SCALE

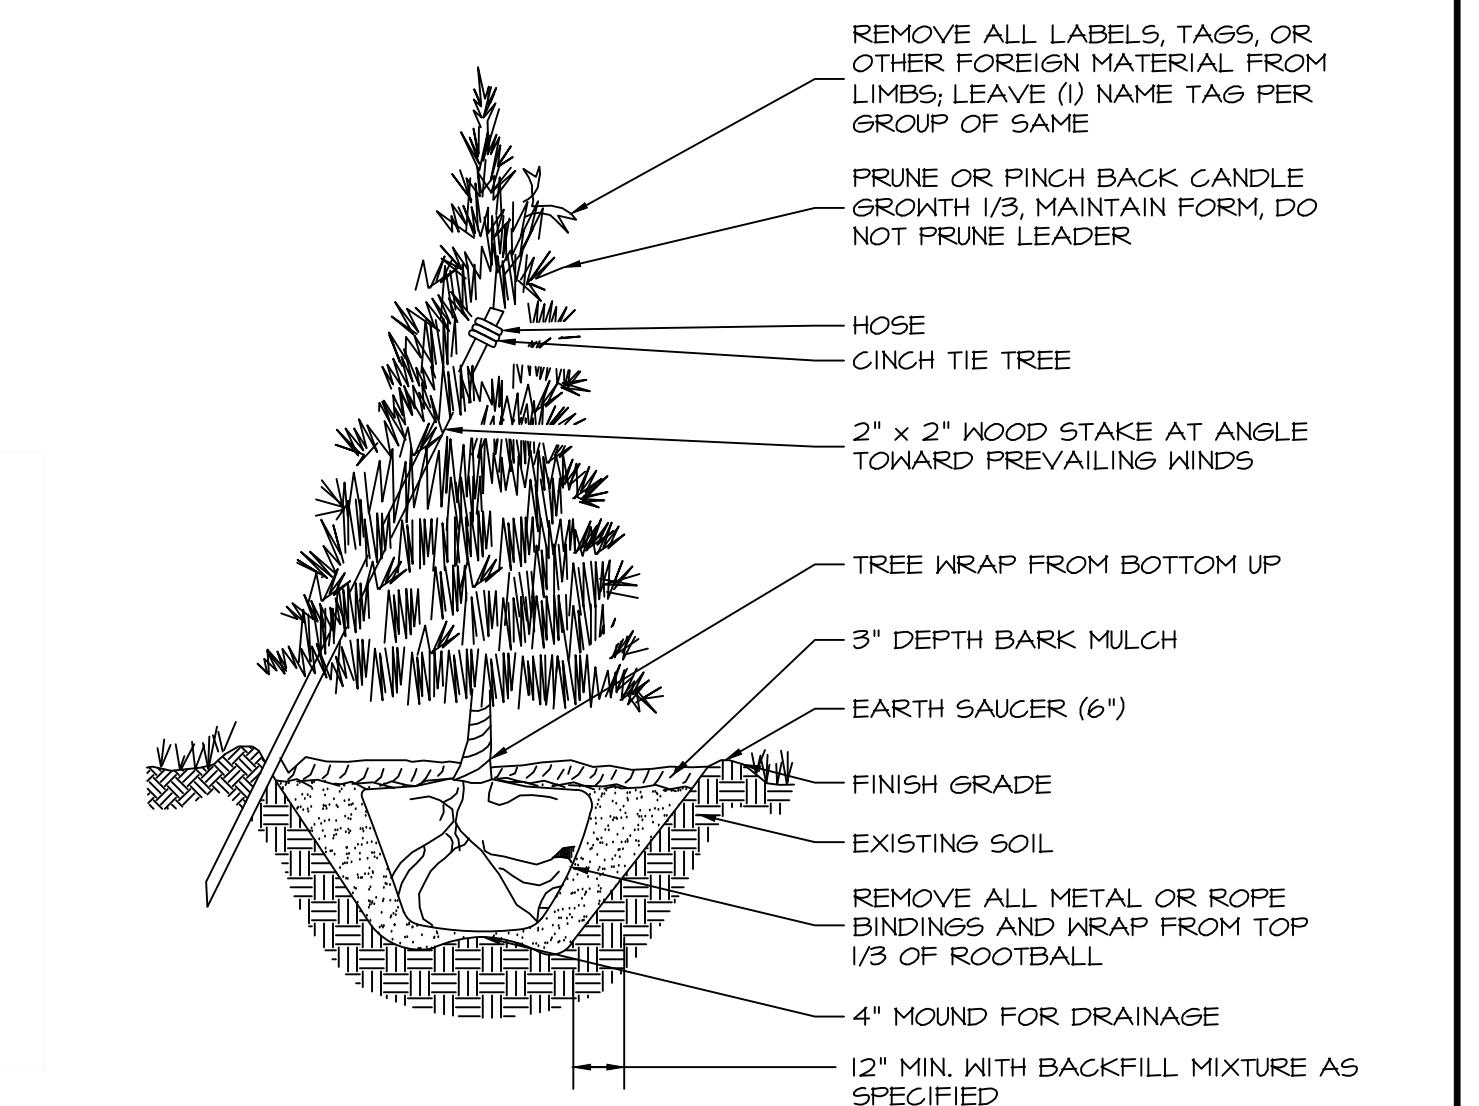

2 LPI
NOT TO SCALE

REMOVE ALL LABELS, TAGS OR OTHER FOREIGN MATERIAL FROM LIMBS
PRUNE OR PINCH BACK CANDLE GROWTH 1/3, MAINTAIN FORM, DO NOT PRUNE LEADER
HOSE CINCH TIE TREE
2" x 2" WOOD STAKE AT ANGLE TOWARD PREVAILING WINDS
TREE WRAP FROM BOTTOM UP
3" DEPTH BARK MULCH
EARTH SAUCER (6")
EXISTING GRADE
REMOVE ALL METAL OR ROPE BINDINGS AND WRAP FROM TOP 1/3 OF ROOTBALL
4" MOUND FOR DRAINAGE
12" MIN. WITH BACKFILL MIXTURE AS SPECIFIED

3 LPI
NOT TO SCALE

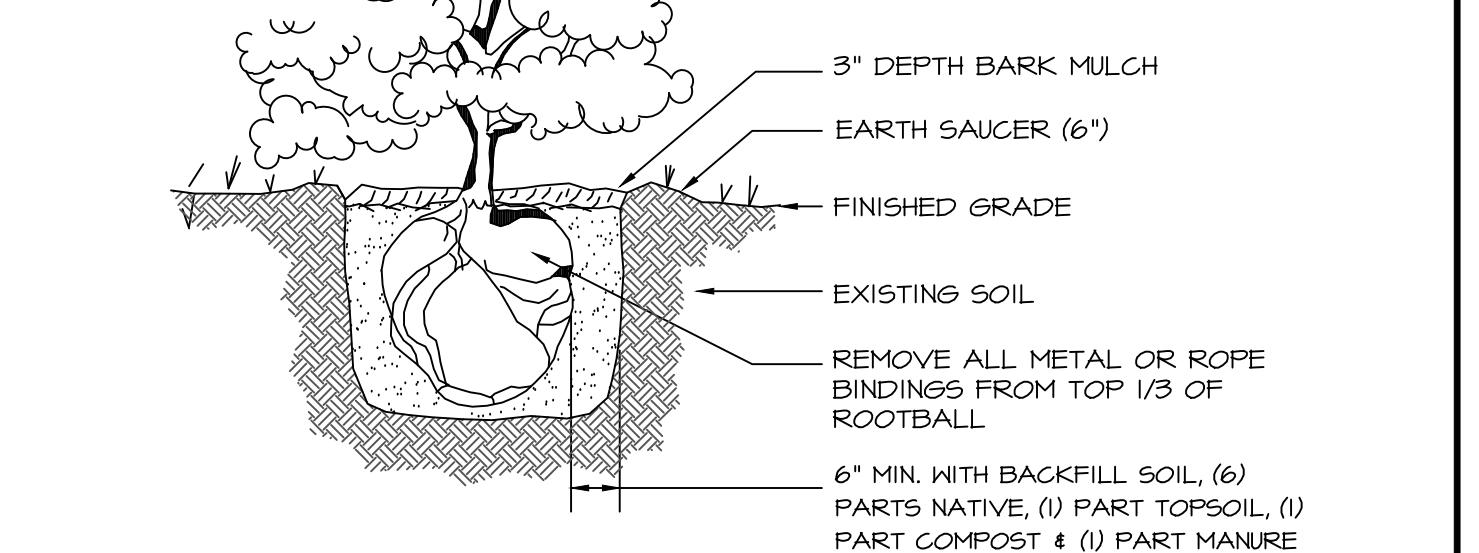

3 LPI
NOT TO SCALE

REMOVE ALL LABELS, TAGS OR OTHER FOREIGN MATERIAL FROM LIMBS
3" DEPTH BARK MULCH
EARTH SAUCER (6")
FINISHED GRADE
EXISTING SOIL
REMOVE ALL METAL OR ROPE BINDINGS FROM TOP 1/3 OF ROOTBALL
6" MIN. WITH BACKFILL SOIL, (6) PARTS NATIVE, (1) PART TOPSOIL, (1) PART COMPOST & (1) PART MANURE

4 LPI
NOT TO SCALE

THIS PLAN IS AN AMENDMENT TO REFERENCE PLAN NO. # OVERALL SITE PLAN AMENDMENT, CARRIAGE LANDING - BRISTOL POINTE NO. 2, 294 YORK STREET, YORK, MAINE APPROVED BY THE TOWN OF YORK PLANNING BOARD ON JUNE 17, 2026. THE PROPOSED AMENDMENT INCLUDES ADDITIONAL REARWARD PARKING AND CHANGES TO ON-SITE STORMWATER MANAGEMENT RELATED TO THE EXISTING MUNICIPAL DRAINAGE EASEMENT.